

LAND CORNER RECORDATION CERTIFICATE

FILING REQUIREMENT OF ACT 74, MICH. P.A.1970

Luce Co.

FOR CORNERS OF--:	LOCATED IN--:	CORNER CODE NUMBER
1. PUBLIC LAND SURVEY_____	T. <u>45</u> ^{N.} S. , R. <u>10</u> ^{E.} W.	<u>F-11</u>
2. PROPERTY CONTROLLING IN SECTION <u>33</u>	T. <u>45</u> ^{N.} S. , R. <u>10</u> ^{E.} W.	<u>1-Sec.33</u>
3. MISCELLANEOUS PROPERTY IN SECTION _____	T. _____ ^{N.} S. , R. _____ ^{E.} W.	_____
4. LOT NO. _____, RECORDED PLAT _____		
5. PRIVATE CLAIMS _____		

REGISTER OF DEEDS STAMP AND FILING NUMBER

I, Billy D. Buckler, do hereby certify that under requirements of P.A. 74, Michigan P.A. of 1970, the corner points mentioned in lines 1 and 2 above were, in a field survey on 3/14, 1977, established, re-established, monumented, re-monumented, recovered or restored as expressed below and in conformance with regulations and rules therefore as required in the current manual of survey instructions of the United States Department of the Interior, Bureau of Land Management or by a decree of a court of law. Furthermore, that the corner points mentioned in lines 3, 4 and 5 above were, in a field survey on _____, 19____, found, recovered, restored, established or re-established as expressed below and in conformance with the rules of the Michigan State Board of Registration for Land Surveyors or, by a Decree of a Court of law:

A. Description of original monument and accessories and/or subsequent restoration:
F-11 Quarter Corner bet. 28-33, set by Wm. Ives, D.S. in 1849.
 Bearings were: Sugar 10, S25°E, 29 lks. and Sugar 14, N28°W, 22 lks.

1-Sec.33 West 1/16 Corner on North side of Section 33.


B. Description of corner evidence found and/or method applied in restoring or re-establishing corner:
F-11 Corner re-established midway and on line bet. two Section Corners.

1-Sec.33 Corner placed midway bet. $\frac{1}{4}$ Corner to East and Section Corner to West.

C. Description of monument for corner and accessories established to perpetuate locating the position of the corner:
 Placed 1" pipe with 4" aluminium cap at the corners.

F-11 New Bearings: **1-Sec.33** Bearings:
 18" Maple, S89°E, 54.0' 20" Maple, S10°W, 27.7'
 18" Maple, N63°W, 50.4' 18" Beech, N37°E, 26.4'

SIGNED BY *Billy D. Buckler* DATE 9/20/77
 Billy D. Buckler
 SURVEYOR'S MICHIGAN REGISTRATION NO. 8887

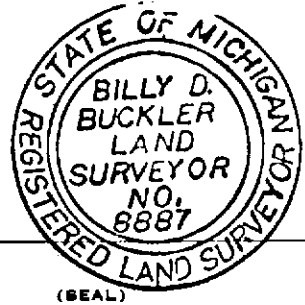

FOR STATE AND UNITED STATES AGENCIES:
 SIGNED BY _____ DATE _____
CHIEF OF SURVEY PARTY
 APPROVED AND SIGNED BY _____ DATE _____
MICHIGAN REGISTERED LAND SURVEYOR