

LAND CORNER RECORDATION CERTIFICATE

FILING REQUIREMENT OF ACT 74, MICH. P.A.1970
 Luce Co. 5 Corners.

FOR CORNERS OF--	LOCATED IN--	CORNER CODE NUMBER
1. PUBLIC LAND SURVEY _____	T. <u>45</u> N. <u>X</u> , R. <u>10</u> K. <u>W.</u>	K-7, J-8, J-7
2. PROPERTY CONTROLLING IN SECTION <u>23</u>	T. <u>45</u> N. <u>X</u> , R. <u>10</u> K. <u>W.</u>	12-Sec.23 10-Sec.23
3. MISCELLANEOUS PROPERTY IN SECTION _____	T. _____ N. _____, R. _____ E. <u>W.</u>	_____
4. LOT NO. _____, RECORDED PLAT _____		
5. PRIVATE CLAIMS _____		

REGISTER OF DEEDS STAMP AND FILING NUMBER

I, Billy D. Buckler, do hereby certify that under requirements of P.A. 74, Michigan P.A. of 1970, the corner points mentioned in lines 1 and 2 above were, in a field survey on 7-25, 1975, established, re-established, monumented, re-monumented, recovered or restored as expressed below and in conformance with regulations and rules therefore as required in the current manual of survey instructions of the United States Department of the Interior, Bureau of Land Management or by a decree of a court of law. Furthermore, that the corner points mentioned in lines 3, 4 and 5 above were, in a field survey on _____, 19____, found, recovered, restored, established or re-established as expressed below and in conformance with the rules of the Michigan State Board of Registration for Land Surveyors or, by a Decree of a Court of law:

A. Description of original monument and accessories and/or subsequent restoration:

- Corners set by Wm Ives, D.S. in 1849.
- K-7 Sec. Cor. 13-14-23-24. Bearings were: Y. Birch 12, N68°E, 40 lks & Sugar 18, S28°W, 47
 - J-8 Center Corner, Section 23.
 - J-7 $\frac{1}{4}$ Cor. Bet. Sec's. 14-23. Bearings were: Hemlock 10, S69°E, 23 lks & Fir 12, N65°W, 21 lks.
- 12-Sec.23 South 1/16 Corner, Sec. 23.
 10-Sec.23 South 1/16 Corner, on westside of Sec.23.

B. Description of corner evidence found and/or method applied in restoring or re-establishing corner:

- K-7 Found large iron bolt buried 4' deep in intersection of roads to North and West.
 - J-8 Corner placed at intersection of lines connecting opposite $\frac{1}{4}$ Corners.
 - J-7 Corner placed in center of an old East-West road and bet. two fence corners (22.0') apart. Distance checks well to Sec. Cors to East and West.
- 12-Sec.23 Corner placed midway bet. Center Cor. to North and South $\frac{1}{4}$ Cor. to South.
 10-Sec.23 Corner placed midway bet. Sec. Cor. to South and $\frac{1}{4}$ Cor. to North.


C. Description of monument for corner and accessories established to perpetuate locating the position of the corner:

- Placed 1" pipe with 4" aluminium cap at all corners --except J-7, where buried 1" pipe.
- K-7 Pipe with cap is buried. New Bearings: Fence Line, East, 40.0' and Fence Line, West, 27.5', and Fence Line, South, 29.0' and Fence line, North, 18.6'.
 - J-8 Bearings are: 11" Hard Maple, S62°W, 18.3' and 10" Hard Maple, S80°E, 2.9'
 - J-7 1" pipe buried in road. New Bearings: 8" Hard Maple, S14°E, 30.6' and 8" Hard Maple, N40°E, 25.5'
- 12-Sec.23 Bearings are: 8" B. Cherry, S63°W, 7.1' and 20" Hard Maple, N24°E, 22.0'
 10-Sec.23 Bearings are: 18" Soft Maple, N62°E, 15.3' and 9" Soft Maple, S71°W, 9.0'

See Sketch on Reverse Side:

SIGNED BY Billy D. Buckler *Billy D. Buckler* DATE 12-17-75

SURVEYOR'S MICHIGAN REGISTRATION NO. 8887

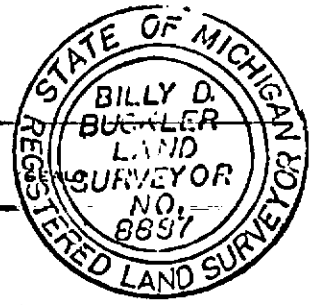

FOR STATE AND UNITED STATES AGENCIES:

SIGNED BY _____ DATE _____
CHIEF OF SURVEY PARTY

APPROVED AND SIGNED BY _____ DATE _____
MICHIGAN REGISTERED LAND SURVEYOR

SURVEYOR'S MICHIGAN REGISTRATION NO. _____