


SEC. 23, T. 45N. R. 10W. LUCE CO.
SUB-DIVISION

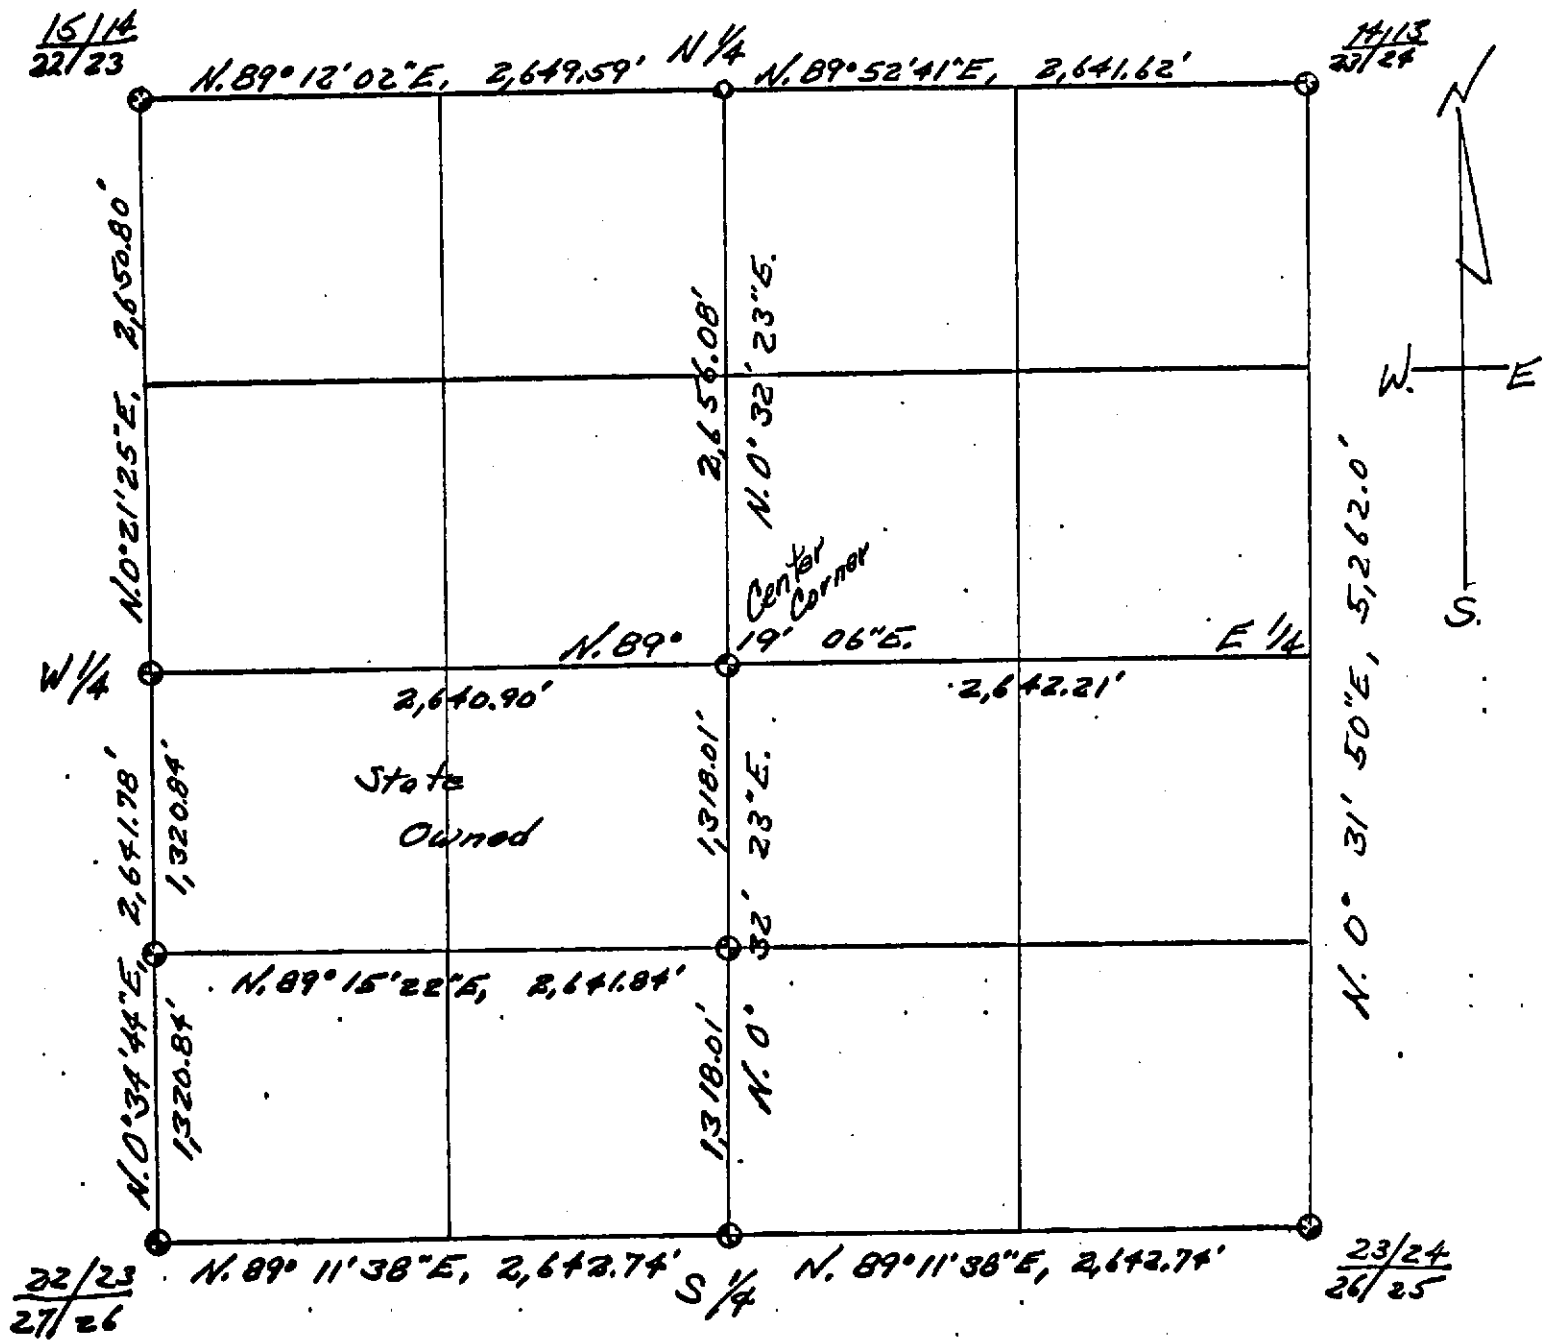

⊙ ----- Dept Marker.

Billy D. Buckler, P.L.S.