

LAND CORNER RECORDATION CERTIFICATE

FILING REQUIREMENT OF ACT 74, MICH. P.A. 1970

LUCE COUNTY Three Corners.

FOR CORNERS OF--	LOCATED IN--	CORNER CODE NUMBER
1. PUBLIC LAND SURVEY _____	T. 45 N. R. 10 W.	E-I2
2. PROPERTY CONTROLLING IN SECTION 33 _____	T. 45 N. R. 10 W.	3-SEC. 33
3. MISCELLANEOUS PROPERTY IN SECTION _____	T. _____ N. S. R. _____ E. W.	10-SEC. 33
4. LOT NO. _____, RECORDED PLAT _____		
5. PRIVATE CLAIMS _____		

REGISTER OF DEEDS STAMP AND FILING NUMBER

I, Billy D. Buckler, RLS, do hereby certify that under requirements of P.A. 74, Michigan P.A. of 1970, the corner points mentioned in lines 1 and 2 above were, in a field survey on 4/23/76, 19____, established, re-established, monumented, re-monumented, recovered or restored as expressed below and in conformance with regulations and rules therefore as required in the current manual of survey instructions of the United States Department of the Interior, Bureau of Land Management or by a decree of a court of law. Furthermore, that the corner points mentioned in lines 3, 4 and 5 above were, in a field survey on _____, 19____, found, recovered, restored, established or re-established as expressed below and in conformance with the rules of the Michigan State Board of Registration for Land Surveyors or, by a Decree of a Court of law:

A. Description of original monument and accessories and/or subsequent restoration:

E-I2; Quarter Corner bet. Secs' 32-33, set by Wm. Ives, D.S. in 1849.
 Bearings were: Sugar 8", S18W, 15 Lks. and Sugar 17", N54E, 26 Lks.
3-SEC. 33; North 1/16 Corner, on West side of Sec. 33.
10- SEC. 33; South 1/16 Corner, on West side of Sec. 33.

B. Description of corner evidence found and/or method applied in restoring or re-establishing corner:


E-I2; Corner re-established midway bet. two Sec. Cors.
 Found no evidence of Original Corner.
3-SEC. 33; Corner placed midway bet. Sec. Cor. to North and Quarter Corner to South.
10-SEC. 33; Corner placed midway bet. Sec. Cor. to South and Quarter Corner to North.

C. Description of monument for corner and accessories established to perpetuate locating the position of the corner:

~~E-I2;~~ Placed 1" Pipe with 4" Aluminum Cap at all Corners.
E-I2; New Bearings:
 17" Soft Maple, S24E, 31.0' and 13" Hard Maple, N73E, 10.9'
3-SEC. 33; New Bearings:
 16" Hard Maple, N84E, 22.2' and 7" Hard Maple, S15W, 19.6'.
10-SEC. 33; New Bearings:
 15" Hard Maple, S17E, 22.8' and 15" Hard Maple, N73W, 27.8'.

SIGNED BY Billy D. Buckler, RLS
 SURVEYOR'S MICHIGAN REGISTRATION NO. 8887.

DATE 9/22/76

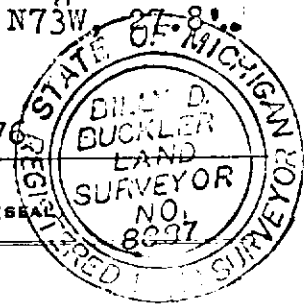

FOR STATE AND UNITED STATES AGENCIES:

SIGNED BY _____ DATE _____
CHIEF OF SURVEY PARTY
 APPROVED AND SIGNED BY _____ DATE _____
MICHIGAN REGISTERED LAND SURVEYOR

SURVEYOR'S MICHIGAN REGISTRATION NO. _____