

SURVEY & REMONUMENTATION

MAY 28 1997

LUCE COUNTY REMONUMENTATION CORNER

COMMISSION

LAND CORNER RECORDATION CERTIFICATE
Filing Requirement of Act 74, Mich. P.A. 1970

LUCE COUNTY REGISTER OF DEEDS

Recorded
Liber 2 Page 725
02-28-1997 08:56:58
Kathy S. Maha
Kathy S. Maha, Register
REGISTER OF DEEDS

For corners in


<u>Luce</u> (County)	Located In:	Corner Code #
1. Public Land Survey	T45N R 10W	<u>A-3</u> Same
	T45N R 11W	M-3 corner
	T ___ R ___	_____
	T ___ R ___	_____
2. Property Controlling in Section	S ___ T ___ R ___	_____
	S ___ T ___ R ___	_____
3. Miscellaneous Property in Sec.	S ___ T ___ R ___	_____
	S ___ T ___ R ___	_____

Register of Deeds Stamp & File Number

4. Lot No. _____, Recorded Plat _____
5. Private Claims _____

I, William L. Karr, in a field survey on Dec. 4, 1996 do hereby state that under requirements of P.A. 74, Michigan P.A. of 1970, the corner points mentioned in lines 1 and 2 above were in conformance with regulations and rules therefore as required in the current manual of survey instructions of the United States Department of the Interior, Bureau of Land Management or by a decree of a Court of Law and /or that the corner points mentioned in lines 3, 4 and 5 above were in conformance with the rules of the Michigan Board of Land Surveyors or by a Decree of a Court of Law; established, re-established, monumented, recovered, found as expressed below:

NOTE: Not more than 2 corners, all in the same town and range, may be recorded on this certificate.

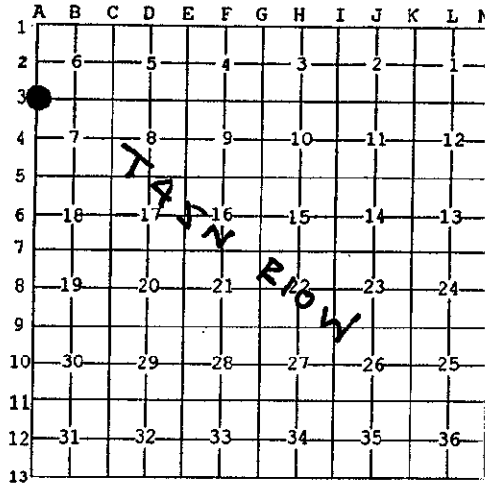

A. Description of original monument and accessories and/or subsequent restoration:

(A-3) Section Corner common to Sections 6 & 7, T.45 N., R.10 W. and Sections 1 & 12, T.45 N., R.11 W.

1841: J. Burt for W.A. Burt set post Cedar 9 N13°E 20 Cedar 12 N67°W 9
1930's: M.D.O.T. construction plans for M-28 show a distance of 2638.74' North to axle shaft from 1/4 corner 12/7.

B. Description of corner evidence found and/or method applied in restoring or reestablishing corner:


(A-3) This Corner is being perpetuated as part of the Luce County Remonumentation Program.

Found no evidence of original corner. Found axle shaft 2638.68' North of 1/4 corner 12/7. Accepted corner position as found.

C. Description of monument for corner and accessories established to perpetuate locating the position of the corner:

(A-3) Corner is a 1-1/4" axle shaft, 1' above grade.

Witnesses:	8" Cedar	N41°E	21.91'
	10" Cedar	S04°W	3.70'
	6" B. Spruce	S75°W	5.80'
	Old Cedar stump w/blaze	N25°W	15.90''
	5" Cedar	N18°W	22.00'

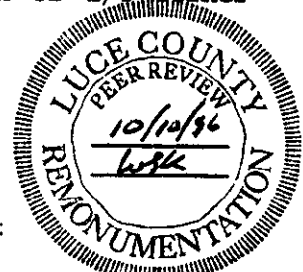

Signed by William L. Karr
Surveyor's Michigan License No. 27450

Date 12-30-96

NOTE: All bearings are compass bearings corrected for declination. All distances are to a nail in side of witness objects unless noted.