

1993

LUCE COUNTY REMONUMENTATION CORNER

COMMISSION

LAND CORNER RECORDATION CERTIFICATE

Filing Requirement of Act 74, Mich. P.A. 1970

For corners in  
Luce

	Located In:	Corner Code #
1. Public Land Survey	T 45N R 10W T 45N R 11W T _____ R _____ T _____ R _____	A-4 Same M-4 Corner
2. Property Controlling in Section	S _____ T _____ R _____ S _____ T _____ R _____	
3. Miscellaneous Property in Sec.	S _____ T _____ R _____ S _____ T _____ R _____	

Filed 12-22 A.D., 1993

At 10:00 o'clock A.M.

File No. 99 498

*Keith R. Waters*  
Luce County Reg. of Deeds

Register of Deeds Stamp & File Number

4. Lot No. \_\_\_\_\_, Recorded Plat \_\_\_\_\_  
5. Private Claims \_\_\_\_\_

	A	B	C	D	E	F	G	H	I	J	K	L	M
2	6		5		4		3		2		1		
3													
4	7		8		9		10		11		12		
5													
6	18		17		16		15		14		13		
7													
8	19		20		21		22		23		24		
9													
10	30		29		28		27		26		25		
11													
12	31		32		33		34		35		36		
13													

I, Keith R. Waters in a field survey on September, 1993, do hereby certify that under requirements of P.A. 74, Michigan P.A. of 1970, the corner points mentioned in lines 1 and 2 above were in conformance with regulations and rules therefore as required in the current manual of survey instructions of the United States Department of the Interior, Bureau of Land Management or by a decree of a Court of Law and/or that the corner points mentioned in lines 3, 4 and 5 above were in conformance with the rules of the Michigan Board of Land Surveyors or by a Decree of a Court of Law; established, re-established, monumented, re-monumented, recovered, found as expressed below:

NOTE: Not more than 4 corners, all in the same town and range, may be recorded on this certificate.

A. Description of original monument and accessories and/or subsequent restoration:


A-4 1/4 Corner Common to Section 7, T45N, R10W, & Section 12, T45N, R11W

Original ties to post: 1977 - This corner is shown on MDOT Luce County Spruce 12, N32°E 14 links right-of-way maps, page 6, at station 249+93.72, Birch 12, N40°W 11 links 50.78 feet south of tangent on Highway M-28.

B. Description of corner evidence found and/or method applied in restoring or reestablishing corner:

A-4

This corner is being perpetuated as part of the Luce County Remonumentation Program. Found an axle shaft on the south side of Highway M-28. Position checks within 0.10' with found highway monuments at P.I. station 246+52.74 and at P.T. station 250+34.72. Accepted corner as found.

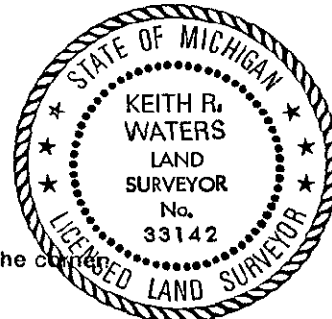

C. Description of monument for corner and accessories established to perpetuate locating the position of the corner:

A-4

Corner is an axle shaft approximately 50' south of centerline of Highway M-28. Witnesses:

- 4" Spruce, S77°W 11.10'
- 3" Spruce, N35°W 7.44'
- 5" Spruce, N56°E 13.95'
- 4" Balsam Fir, S65°E 22.17'

Note: Distances are to a nail and tag in the side of the witness object. Trees are blazed and painted. Bearings are compass bearings corrected for declination.

Signed by Keith R. Waters

Date 12-20-93

Surveyor's Michigan License No. 33142