

**SURVEY & REMONUMENTATION**

MAR 19 1999

**LAND CORNER RECORDATION CERTIFICATE**  
**Filing Requirement of Act 74, Mich. P.A. 1970**  
**Luce County Remonumentation Corners**

For corners in **SECTION**


Luce County	Located in:	Corner Code #
1. Public Land Survey	T45N R10W	B-1 } Same ✓
	T46N R10W	B-13 } Corner
	T45N R10W	C-1 } Same
	T46N R10W	C-13 } Corner
2. Property Controlling in Section	S T R	
	S T R	
3. Miscellaneous Property in Sec.	S T R	
	S T R	
4. Lot No. , Recorded Plat		
5. Private Claims		

LUCE COUNTY  
 REGISTER OF DEEDS  
 Recorded  
*Liber 3 Page 862*  
 02-25-1999 15:37:42  
*Deborah Johnson, Dep.*  
 Kathy S. Mahar, Register  
 REGISTER OF DEEDS

Register of Deeds Stamp & File Number

I, Keith R. Waters, in a field survey on July 1, 1998, do hereby state that under requirements of P.A. 74, Michigan P.A. of 1970, the corner points mentioned in lines 1 and 2 above were in conformance with regulations and rules therefore as required in the current manual of survey instructions of the United States Department of the Interior, Bureau of Land Management or by a decree of a Court of Law and /or that the corner points mentioned in lines 3, 4 and 5 above were in conformance with the rules of the Michigan Board of Land Surveyors or by a Decree of a Court of Law; established, re-established, monumented, recovered, found as expressed below:

NOTE: Not more than 2 corners, all in the same town and range, may be recorded on this certificate.

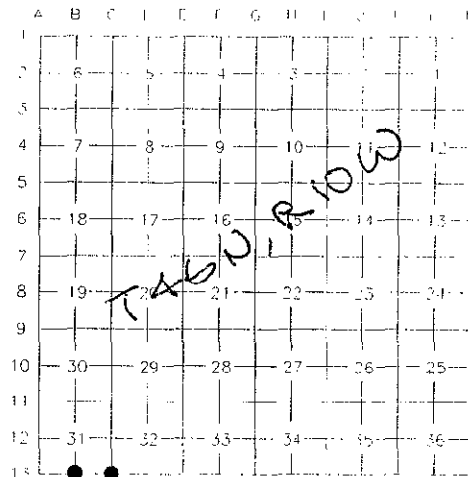

A. Description of original monument and accessories and/or subsequent restoration:  
B-13 1/4 Corner Common to Sec. 6, T45N, R10W & Sec. 31, T46N, R10W

1841 - Original corner was established by William A. Burt.  
 Witnesses: Cedar 7, N39°E 16 links - Cedar 8, N70°W 26 links.  
 Found no evidence of subsequent restoration of this corner.

C-13 Corner Common to Secs. 5 & 6, T45N, R10W & Secs. 31 & 32, T46N, R10W

1841 - Original corner was established by William A. Burt.  
 Witnesses: Fir 9, S63°E 09 links - Fir 9, N63°W 24 links.  
 1849 - Witnesses added by William Ives during the subdivision of Town 45 North, Range 10 West:  
 Cedar 12, S57°E 12 links - Cedar 10, S60°W 62 links.  
 Found no evidence of subsequent restoration of this corner.

B. Description of corner evidence found and/or method applied in restoring or reestablishing corner:

B-13  
 This corner is being reestablished as part of the Luce County Remonumentation Program.  
 Found no evidence of the original corner. Reestablished corner by single proportionate measurement on the township line between recovered corners at A-13 and I-13.

C-13  
 This corner is being reestablished as part of the Luce County Remonumentation Program.  
 Found no evidence of the original corner. Reestablished corner by single proportionate measurement on the township line between recovered corners at A-13 and I-13.

C. Description of monument for corner and accessories established to perpetuate locating the position of the corner:

B-13  
 Placed a 1/2" x 48" rebar with a stamped aluminum Luce County Remonumentation cap at the corner location  
 Witnesses:  
 Nail and tag #33142 in side of blazed 4" Cedar, S05°E 25.64'  
 Nail and tag #33142 in side of blazed 8" Cedar, N72°E 7.60'  
 Nail and tag #33142 in side of blazed 9" Cedar, N21°W 8.35'  
 Nail and tag #33142 in side of blazed 5" Cedar, S60°W 1.76'  
 Nail and tag #33142 in side of blazed 4" Balsam Fir, S43°W 18.50'

C-13  
 Placed a 1/2" x 48" rebar with a stamped aluminum Luce County Remonumentation cap at the corner location  
 Witnesses:  
 Nail and tag #33142 in side of blazed 7" Tamarack, S06°E 21.29'  
 Nail and tag #33142 in side of blazed 7" Tamarack, S39°W 45.69'  
 Nail and tag #33142 in side of blazed 6" Tamarack, WEST 172.20'  
 Nail and tag #33142 in side of blazed 4" Tamarack, N33°W 67.22'

Signed by Keith R. Waters

Date 12-29-98

Surveyor's Michigan License No. 33142

