

SURVEY & REMONUMENTATION

LAND CORNER RECORDATION CERTIFICATE

MAR 13 2000

Filing Requirement of Act 74, Mich. P.A. 1970

Luce County Remonumentation Corner

For corners in

Luce County	SECTION	Located in:	Corner Code #
1. Public Land Survey		T45N R10W	B-5
		T R	
		T R	
		T R	
2. Property Controlling in Section	S	T R	
	S	T R	
3. Miscellaneous Property in Sec.	S	T R	
	S	T R	

LUCE COUNTY
 REGISTER OF DEEDS
 Recorded
Liber 3 Page 907
 02-08-2000 13:02:06
Kathryn S. Mahar
 Kathryn S. Mahar, Register
 REGISTER OF DEEDS

Register of Deeds Stamp & File Number

- 4. Lot No. , Recorded Plat
- 5. Private Claims

I, Keith R. Waters, in a field survey on December 1, 1999, do hereby state that under requirements of P.A. 74, Michigan P.A. of 1970, the corner points mentioned in lines 1 and 2 above were in conformance with regulations and rules therefore as required in the current manual of survey instructions of the United States Department of the Interior, Bureau of Land Management or by a decree of a Court of Law and /or that the corner points mentioned in lines 3, 4 and 5 above were in conformance with the rules of the Michigan Board of Land Surveyors or by a Decree of a Court of Law; established, re-established, monumented, recovered, found as expressed below:

NOTE: Not more than 2 corners, all in the same town and range, may be recorded on this certificate.

A. Description of original monument and accessories and/or subsequent restoration:

B-5 1/4 Corner Common to Sections 7 & 18, T45N, R10W

1849 – Original corner established by William Ives.
 Witnesses: Cedar 14, N10°W 12 links – Cedar 12, S10°E 15 links.

Found no evidence of subsequent restoration of this corner.

B. Description of corner evidence found and/or method applied in restoring or reestablishing corner:


This corner is being reestablished as part of the Luce County Remonumentation Program. Found no evidence of the original corner. Reestablished corner by single proportionate measurement on line between the section corner on the range line at A-5 to the west and the section corner at C-5 to the east. The distance between said section corners is within 1 foot of the original GLO distance.

C. Description of monument for corner and accessories established to perpetuate locating the position of the corner:

Placed a 1/2" x 18" rebar with a stamped aluminum Luce County Remonumentation cap at the corner location.

- Witnesses:
- Nail and tag #33142 in 12" blazed Spruce, S57°E 20.04'
 - Nail and tag #33142 in 12" blazed Aspen, N15°W 126.88'
 - Nail and tag #33142 in 6" blazed Aspen, N42°W 44.86'
 - Nail and tag #33142 in 17" blazed Twin Spruce, S47°W 92.35'

	A	B	C	D	E	F	G	H	I	J	K	L	M
1													
2		6		5		4		3		2		1	
3													
4		7		8		9		10		11		12	
5													
6		18		17		16		15		14		13	
7													
8		19		20		21		22		23		24	
9													
10		30		29		28		27		26		25	
11													
12		31		32		33		34		35		36	
13													

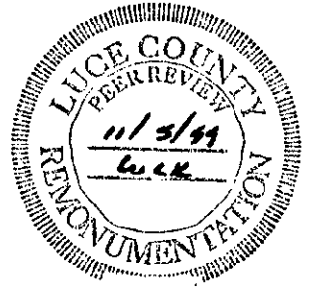

Signed by Keith R. Waters

Date 12-29-99

Surveyor's Michigan License No. 33142