

COMMISSION

LAND CORNER RECORDATION CERTIFICATE
Filing Requirement of Act 74, Mich. P.A. 1970

For corners in
Luce

(County)	Located In:	Corner Code #
1. Public Land Survey	T 45N R 10W	C-5
	T R	
	T R	
	T R	
2. Property Controlling in Section	S T R	
	S T R	
3. Miscellaneous Property in Sec.	S T R	
	S T R	
4. Lot No. _____, Recorded Plat _____		
5. Private Claims _____		


Filed 12-22 A.D., 1993

At 10:00 o'clock A.M.

File No. 99 492
Keith R. Waters
Luce County Reg. of Deeds

Register of Deeds Stamp & File Number

I, Keith R. Waters, in a field survey on September, 1993, do hereby certify that under requirements of P.A. 74, Michigan P.A. of 1970, the corner points mentioned in lines 1 and 2 above were in conformance with regulations and rules therefore as required in the current manual of survey instructions of the United States Department of the Interior, Bureau of Land Management or by a decree of a Court of Law and/or that the corner points mentioned in lines 3, 4 and 5 above were in conformance with the rules of the Michigan Board of Land Surveyors or by a Decree of a Court of Law; established, re-established, monumented, re-monumented, recovered, found as expressed below:

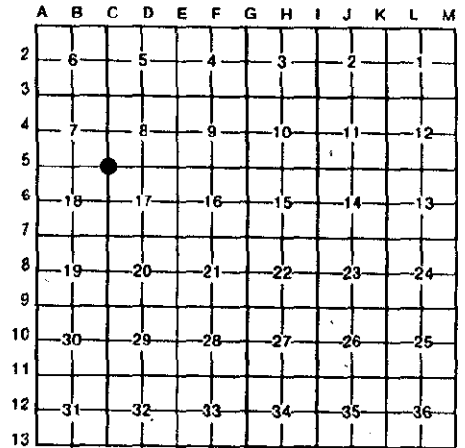

NOTE: Not more than 4 corners, all in the same town and range, may be recorded on this certificate.

A. Description of original monument and accessories and/or subsequent restoration:
C-5 Corner Common to Sections 7, 8, 17, & 18, T45N, R10W

Original ties to post: 1978 - This corner is shown on MDOT Luce County Cedar 9, S45°W 20 links right-of-way maps, page 6, as being 2644.50 feet Cedar 12, N73°E 17 links south of 1/4 corner between Sections 7 and 8.



B. Description of corner evidence found and/or method applied in restoring or reestablishing corner:
C-5

This corner is being re-established as part of the Luce County Remonumentation Program. Found no evidence of corner, was probably destroyed during road construction. Re-established corner 2644.50 feet south of 1/4 corner between Sections 7 and 8. East-west position determined using record angle from alignment on Highway M-28, using found Highway monumentation at P.I. station 296+55.74 and at P.T. station 308+95.24. Corner is at the north edge of a wooded area to the east.

C. Description of monument for corner and accessories established to perpetuate locating the position of the corner:

C-5
Corner is a 1/2" rebar with 3/4" aluminum Luce County cap 8 feet east of the east edge of pavement on County Road 425. Witnesses:

- 8" Red Maple, S68°W 63.86'
- 8" Spruce, S78°E 55.94'
- 7" Spruce, S55°E 66.14'
- 8" Balsam Fir, S31°E 35.84'

Note: Distances are to a nail and tag in side of the tree. Trees are blazed and painted. Bearings are compass bearings corrected for declination.

Signed by Keith R. Waters

Date 12-20-93

Surveyor's Michigan License No. 33142