

**SURVEY & REMONUMENTATION**

APR 28 1995

LUCE COUNTY REMONUMENTATION CORNER

**COMMISSION**

**LAND CORNER RECORDATION CERTIFICATE**

Filing Requirement of Act 74, Mich. P.A. 1970

For corners in Luce

Located In: \_\_\_\_\_ Corner Code # \_\_\_\_\_

(County) \_\_\_\_\_


1. Public Land Survey T 45N R 10W C-7  
 T \_\_\_\_\_ R \_\_\_\_\_  
 T \_\_\_\_\_ R \_\_\_\_\_  
 T \_\_\_\_\_ R \_\_\_\_\_

2. Property Controlling in Section S \_\_\_\_\_ T \_\_\_\_\_ R \_\_\_\_\_  
 S \_\_\_\_\_ T \_\_\_\_\_ R \_\_\_\_\_

3. Miscellaneous Property in Sec. S \_\_\_\_\_ T \_\_\_\_\_ R \_\_\_\_\_  
 S \_\_\_\_\_ T \_\_\_\_\_ R \_\_\_\_\_

4. Lot No. \_\_\_\_\_, Recorded Plat \_\_\_\_\_

5. Private Claims \_\_\_\_\_

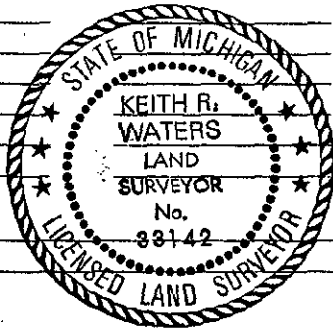

Filed 1/20 A.D., 19 95  
 At 12:30 o'clock P.M.  
 Liber 2  
 File No. page 623  
Ruth S. Mahan  
 Luce County Reg. of Deeds  
 Register of Deeds Stamp & File Number

	A	B	C	D	E	F	G	H	I	J	K	L	M
2	6	5	4	3	2	1							
3													
4	7	8	9	10	11	12							
5													
6	16	17	18	15	14	13							
7													
8	19	20	21	22	23	24							
9													
10	30	29	28	27	26	25							
11													
12	31	32	33	34	35	36							
13													

I, Keith R. Waters in a field survey on November 16, 19 94 do hereby certify that under requirements of P.A. 74, Michigan P.A. of 1970, the corner points mentioned in lines 1 and 2 above were in conformance with regulations and rules therefore as required in the current manual of survey instructions of the United States Department of the Interior, Bureau of Land Management or by a decree of a Court of Law and/or that the corner points mentioned in lines 3, 4 and 5 above were in conformance with the rules of the Michigan Board of Land Surveyors or by a Decree of a Court of Law; established, re-established, monumented, re-monumented, recovered, found as expressed below:

**NOTE: Not more than 4 corners, all in the same town and range, may be recorded on this certificate.**

A. Description of original monument and accessories and/or subsequent restoration:


C-7 Corner Common to Sections 17, 18, 19, & 20, T45N, R10W

Original ties to post: Fir 8, N64°E 29 links Beech 8, S60°W 22 links  
 1979 - Corner shown on a survey drawing by Thomas L. Kelly, RLS 24599, as set 1/2" iron with cap #24599. Recorded on page 23, Luce County surveys.  
 1985 - Eino Sainio, P.S. 7873, recorded on page 362, Luce County corner records. Set railroad spike over buried iron in road. Witnesses:  
 P. Pole, N42°W 45.0' - Red Pine, S41°E 74.0' - Fence Post, S44°W 48.0'

B. Description of corner evidence found and/or method applied in restoring or reestablishing corner:

C-7 (T45N, R10W)

This corner is being perpetuated as part of the Luce County Remonumentation Program. Found a railroad spike in approximate intersecting centerlines of County Road 425 north-south and County Road 458 east-west. Power pole and red pine witnesses from 1985 recording are still standing and check well. Corner has been used to establish other corners in the area. Accepted corner as found and established new witness objects.

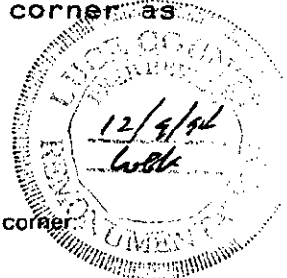

C. Description of monument for corner and accessories established to perpetuate locating the position of the corner:

C-7  
 Corner is a railroad spike in the intersection of County Roads 425 and 458.  
 Witnesses:

- Power Pole (NY2-22-31), N80°W 156.31'
- Power Pole (NY2-22-30), N46°W 48.10'
- 5" Sugar Maple, N34°E 85.76'
- 10" Red Pine, S48°E 74.05'

Note: Distances are to a nail and tag in the side of witness object. Trees are blazed and painted. Bearings are compass bearings corrected for declination.

Signed by Keith R. Waters Date 12-23-94

Surveyor's Michigan License No. 33142