

1993

LUCE COUNTY REMONUMENTATION CORNER

COMMISSION

LAND CORNER RECORDATION CERTIFICATE
Filing Requirement of Act 74, Mich. P.A. 1970

For corners in Luce

(County)	Located In:	Corner Code #
1. Public Land Survey	T <u>45N</u> R <u>10W</u>	C-8
	T _____ R _____	_____
	T _____ R _____	_____
	T _____ R _____	_____
2. Property Controlling in Section	S _____ T _____ R _____	_____
	S _____ T _____ R _____	_____
3. Miscellaneous Property in Sec.	S _____ T _____ R _____	_____
	S _____ T _____ R _____	_____
4. Lot No. _____, Recorded Plat _____		
5. Private Claims _____		

Filed 12-22 A.D., 1993

At 10:00 o'clock A M.

File No. 99 495

Nancy S. Mahar
Luce County Reg. of Deeds

Register of Deeds Stamp & File Number

I, Keith R. Waters, in a field survey on September, 1993, do hereby certify that under requirements of P.A. 74, Michigan P.A. of 1970, the corner points mentioned in lines 1 and 2 above were in conformance with regulations and rules therefore as required in the current manual of survey instructions of the United States Department of the Interior, Bureau of Land Management or by a decree of a Court of Law and/or that the corner points mentioned in lines 3, 4 and 5 above were in conformance with the rules of the Michigan Board of Land Surveyors or by a Decree of a Court of Law; established, re-established, monumented, re-monumented, recovered, found as expressed below:


NOTE: Not more than 4 corners, all in the same town and range, may be recorded on this certificate.

	A	B	C	D	E	F	G	H	I	J	K	L	M
2	6	5	4	3	2	1							
3													
4	7	8	9	10	11	12							
5													
6	18	17	16	15	14	13							
7													
8	19	20	21	22	23	24							
9													
10	30	29	28	27	26	25							
11													
12	31	32	33	34	35	36							
13													

A. Description of original monument and accessories and/or subsequent restoration:

C-8 1/4 Corner Common to Sections 19 & 20, T45N, R10W

Original to post:
Birch 18" links
Sugar 8" 75°W 48' links

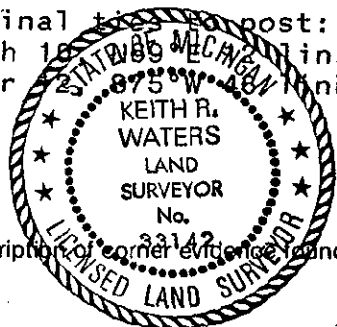

1978 - This corner is shown on a survey recorded by Thomas M. Kelly, R.L.S. 24599, in Book 1, Page 23 of Luce County recorded surveys as a 1/2" iron with cap 24599. Ties: 8" Maple, N75°E 42.16'
Iron w/cap, S89°29'24"E 45.00'
Iron w/cap, N89°59'42"W 21.00'

B. Description of corner evidence found and/or method applied in restoring or reestablishing corner:

C-8

This corner is being perpetuated as part of the Luce County Remonumentation Program. Found a 1/2" iron with cap 24599 on the west edge of north-south gravel road (County Road 425) as shown on Kelly survey. According to Kelly survey, corner is mid-way on line between Section corners north and south. Also found 2 witness irons as shown on Kelly survey. No measuring nail was found in 8" maple, distance to center checks well. Accepted corner position as found. Replaced plastic cap 24599 with a 3 1/2" aluminum Luce County cap.

C. Description of monument for corner and accessories established to perpetuate locating the position of the corner:

C-8

Corner is a 1/2" rebar with 3 1/2" aluminum Luce County cap at the west edge of County Road 425 (gravel). Witnesses:

- 5" Sugar Maple, N63°E 50.34'
- 7" Sugar Maple, S83°E 43.93'
- 8" Sugar Maple, S45°E 52.58'
- Power Pole (NY2-22C-7), S22°W 73.48'
- 1/2" Iron w/cap #24599, EAST 45.14'
- 1/2" Iron w/cap #24599, WEST 21.00'

Note: Distance to trees and pole is is to a nail and tag in the side. Trees are blazed. Bearings are compass bearings corrected for declination.

Signed by Keith R. Waters

Date 12-20-93

Surveyor's Michigan License No. 33142