

MAR 13 2000

LAND CORNER RECORDATION CERTIFICATE
Filing Requirement of Act 74, Mich. P.A. 1970
Luce County Remonumentation Corner

SECTION

For corners in

Luce County	Located in:	Corner Code #
1. Public Land Survey	T45N R10W	E-6
	T R	
	T R	
	T R	
2. Property Controlling in Section	S T R	
	S T R	
3. Miscellaneous Property in Sec.	S T R	
	S T R	

LUCE COUNTY
REGISTER OF DEEDS
Recorded
Liber 3 Page 901
02-08-2000 13:00:36
Kathy S. Mahar
Kathy S. Mahar, Register
REGISTER OF DEEDS

Register of Deeds Stamp & File Number

4. Lot No. , Recorded Plat
5. Private Claims

I, Keith R. Waters, in a field survey on December 8, 1999, do hereby state that under requirements of P.A. 74, Michigan P.A. of 1970, the corner points mentioned in lines 1 and 2 above were in conformance with regulations and rules therefore as required in the current manual of survey instructions of the United States Department of the Interior, Bureau of Land Management or by a decree of a Court of Law and /or that the corner points mentioned in lines 3, 4 and 5 above were in conformance with the rules of the Michigan Board of Land Surveyors or by a Decree of a Court of Law; established, re-established, monumented, recovered, found as expressed below:

NOTE: Not more than 2 corners, all in the same town and range, may be recorded on this certificate.

A. Description of original monument and accessories and/or subsequent restoration:

E-6 1/4 Corner Common to Sections 16 & 17, T45N, R10W

1849 - Original corner established by William Ives.
Witnesses: Cedar 9, S55°W 04 links - Cedar 10, N54°E 09 links.

Found no evidence of subsequent restoration of this corner.

B. Description of corner evidence found and/or method applied in restoring or reestablishing corner:


This corner is being perpetuated as part of the Luce County Remonumentation Program. Found a wood post, broken off and laying down. The found wood post is 2636.8 feet north of the section corner at E-7 (GLO distance is 2640 feet) and is 1051.2 feet south of a similar found post at the meander corner on the south shore of Kak's Lake (GLO distance is 1059.3 feet). I believe that the post may have been set by Harold C. Lawrence, R.L.S. #3218, as a perpetuation of the original corner location. Accepted corner as found and set a rebar and a stamped aluminum Luce County Remonumentation cap in the stub of the broken off post.

C. Description of monument for corner and accessories established to perpetuate locating the position of the corner:

Placed a 1/2" x 18" rebar with a stamped aluminum Luce County Remonumentation cap at the corner location, at the base of a found broken off wood post.

Witnesses:

- Nail and tag #33142 in 5" blazed Cedar, S85°W 5.09'
- Nail and tag #33142 in 9" blazed Cedar, N03°E 21.66'
- Nail and tag #33142 in 11" blazed Cedar, N45°E 11.29'
- Nail and tag #33142 in 7" blazed Cedar, S52°E 29.43'

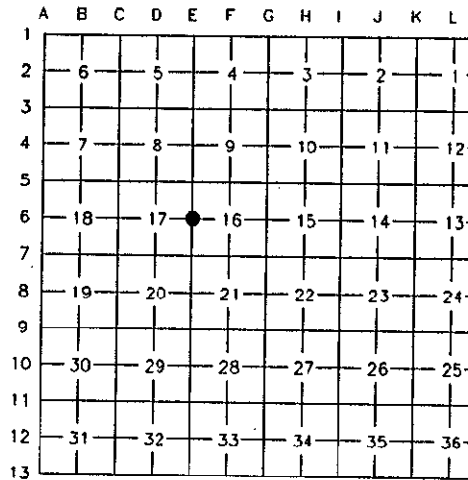

Signed by Keith R. Waters

Date 12-29-99

Surveyor's Michigan License No. 33142