

1993

LUCE COUNTY REMONUMENTATION CORNER

COMMISSION

LAND CORNER RECORDATION CERTIFICATE
Filing Requirement of Act 74, Mich. P.A. 1970

For corners in Luce

(County)	Located In:	Corner Code #
1. Public Land Survey	T 45N R 10W	E-10
	T R	
	T R	
	T R	
2. Property Controlling in Section	S T R	
	S T R	
3. Miscellaneous Property in Sec.	S T R	
	S T R	
4. Lot No. _____, Recorded Plat _____		
5. Private Claims _____		

Filed 12-22 A.D.; 1993

At 10:00 o'clock A.M.

File No. 49 485

Keith R. Waters
Luce County Reg. of Deeds

Register of Deeds Stamp & File Number

Keith R. Waters November 93

I, _____, in a field survey on _____, 19____, do hereby certify that under requirements of P.A. 74, Michigan P.A. of 1970, the corner points mentioned in lines 1 and 2 above were in conformance with regulations and rules therefore as required in the current manual of survey instructions of the United States Department of the Interior, Bureau of Land Management or by a decree of a Court of Law and/or that the corner points mentioned in lines 3, 4 and 5 above were in conformance with the rules of the Michigan Board of Land Surveyors or by a Decree of a Court of Law; established, re-established, monumented, re-monumented, recovered, found as expressed below:

NOTE: Not more than 4 corners, all in the same town and range, may be recorded on this certificate.

A. Description of original monument and accessories and/or subsequent restoration:

E-10 1/4 Corner Common to Sections 28 & 29, T45N, R10W

Original ties to post: Corner is recorded in book 2, page 454, Luce County corner records, by Stephan J. Szyszkoski, P.S. 33986, as set 1" pipe with plastic DNR cap.
Beech 6, S06°E 18 links
Sugar 12, N14°W 24 links
Witnesses: 5" Maple, S08°E 40.2'
8" Maple, N72°W 20.18'
7" Maple, N13°W 24.80'
5" Maple, S87°E 12.18'


B. Description of corner evidence found and/or method applied in restoring or reestablishing corner:

E-10
This corner is being perpetuated as part of the Luce County Remonumentation Program. Found a 1" iron pipe with plastic DNR cap #33986 in the center of a north-south abandoned road. Corner was set equidistant between Section corners north and south. All four bearing trees are intact with measuring nails in sides and check well to found iron. Accepted corner as found.

C. Description of monument for corner and accessories established to perpetuate locating the position of the corner:

E-10
Corner is a 1" iron pipe with plastic DNR cap #33986 in the centerline of north-south abandoned road, east of Highway M-117. Witnesses:

5" Maple, S08°E 40.11'
8" Maple, N72°W 20.13'
7" Maple, N13°W 24.78'
5" Maple, S87°E 12.18'
Note: Distances are to a nail and DNR tag in the side of tree. Trees are blazed. Bearings are compass bearings corrected for declination.

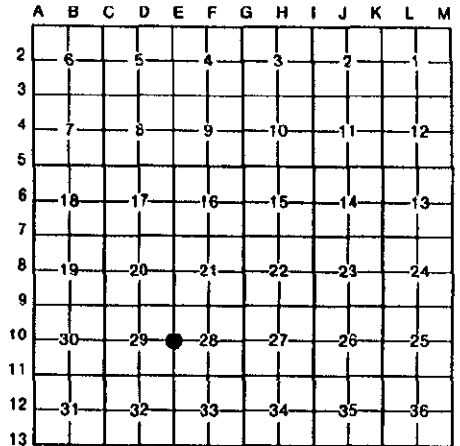

Signed by Keith R. Waters

Date 12-20-93

Surveyor's Michigan License No. 33142