

LAND CORNER RECORDATION CERTIFICATE
Filing Requirement of Act 74, Mich. P.A. 1970
Luce County Remonumentation Corner

MAR 13 2000

SECTION

For corners in

Luce County	Located in:	Corner Code #
1. Public Land Survey	T45N R10W	F-5
	T R	
	T R	
	T R	
2. Property Controlling in Section	S T R	
	S T R	
3. Miscellaneous Property in Sec.	S T R	
	S T R	
4. Lot No.		, Recorded Plat
5. Private Claims		

LUCE COUNTY
REGISTER OF DEEDS
Recorded
Liber 3 Page 899
02-08-2000 13:00:12
Kathy S. Mahar
Kathy S. Mahar, Register
REGISTER OF DEEDS
Register of Deeds Stamp & File Number

	A	B	C	D	E	F	G	H	I	J	K	L	M
1													
2	6	5	4	3	2	1							
3													
4	7	8	9	10	11	12							
5													
6	18	17	16	15	14	13							
7													
8	19	20	21	22	23	24							
9													
10	30	29	28	27	26	25							
11													
12	31	32	33	34	35	36							
13													

I, Keith R. Waters, in a field survey on December 9, 1999, do hereby state that under requirements of P.A. 74, Michigan P.A. of 1970, the corner points mentioned in lines 1 and 2 above were in conformance with regulations and rules therefore as required in the current manual of survey instructions of the United States Department of the Interior, Bureau of Land Management or by a decree of a Court of Law and for that the corner points mentioned in lines 3, 4 and 5 above were in conformance with the rules of the Michigan Board of Land Surveyors or by a Decree of a Court of Law; established, re-established, monumented, recovered, found as expressed below:

NOTE: Not more than 2 corners, all in the same town and range, may be recorded on this certificate.


A. Description of original monument and accessories and/or subsequent restoration:

F-5 1/4 Corner Common to Sections 9 & 16, T45N, R10W

1849 – Original corner established by William Ives.
Witnesses: Fir 6, N15°W 04 links – Fir 6, S07°W 23 links.

1966 – John P. Smallwood, R.L.S. 16944, Michigan State Highway Department Surveyor. Found a 4" squared post.
Witnesses: 3" Ash, S48°W 10.85' – 3" Ash, S35°E 14.58' – 8" Ash, S80°E 29.50'.

1990 – Neil E. Hill, P.S. 27447, Michigan Department of Transportation Surveyor. LCRC recorded in File No. 421, Luce County Corner Records. Found rotted off 4" squared wood post and remains of witnesses of record. Set a 1" x 48" steel bar in rotted base of post. New witnesses:
4" Dead Ash (record witness tree), S50°E 13.83'
12" Dead Ash (record witness tree which is 2' south of 1 cu. yd. granite boulder), S75°E 29.38'
8" Spruce, N05°E 16.04'
5" Cherry, N60°E 22.50'
3" Balsam Fir, S80°W 4.64'

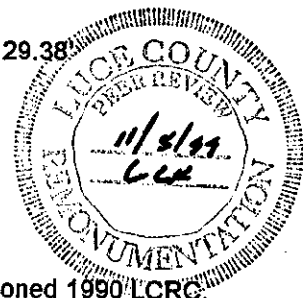

B. Description of corner evidence found and/or method applied in restoring or reestablishing corner:

This corner is being perpetuated as part of the Luce County Remonumentation Program. Found a 1" steel bar and the remains of all record bearing trees as called for in the above mentioned 1990 LCRC. Only the spruce and cherry remain alive and standing. Accepted corner as found and established new bearing trees.

C. Description of monument for corner and accessories established to perpetuate locating the position of the corner:

Found a 1" diameter steel bar at the corner location.
Witnesses:
Nail and MDOT tag in 9" Spruce, N05°E 16.04'
Nail and MDOT tag in 7" Cherry, N73°E 22.50'
Nail and tag #33142 in 6" Balsam Fir, S67°W 9.81'
Nail and tag #33142 in 9" Balsam Fir, S15°E 37.63'

Signed by Keith R. Waters

Date 12-29-99

Surveyor's Michigan License No. 33142