

MAR 1 9 1999

LAND CORNER RECORDATION CERTIFICATE
Filing Requirement of Act 74, Mich. P.A. 1970
Luce County Remonumentation Corner

SECTION

For corners in

Luce County	Located in:	Corner Code #
1. Public Land Survey	T45N R10W T46N R10W T R T R	I-1 \ Same ✓ 1-13/ Corner
2. Property Controlling in Section	S T R S T R	
3. Miscellaneous Property in Sec.	S T R S T R	
4. Lot No. , Recorded Plat		
5. Private Claims		

LUCE COUNTY
 REGISTER OF DEEDS
 Recorded
 Liber 3 Page 866
 02-25-1999 15:38:32
Deborah Johnson, Dep.
 Kathy S. Maher, Register
 REGISTER OF DEEDS

Register of Deeds Stamp & File Number

	A	B	C	D	E	F	G	H	I	J	K	L	M
1													
2													
T46N R10W

I, Keith R. Waters, in a field survey on December 1, 1998, do hereby state that under requirements of P.A. 74, Michigan P.A. of 1970, the corner points mentioned in lines 1 and 2 above were in conformance with regulations and rules therefore as required in the current manual of survey instructions of the United States Department of the Interior, Bureau of Land Management or by a decree of a Court of Law and /or that the corner points mentioned in lines 3, 4 and 5 above were in conformance with the rules of the Michigan Board of Land Surveyors or by a Decree of a Court of Law, established, re-established, monumented, recovered, found as expressed below:

NOTE: Not more than 2 corners, all in the same town and range, may be recorded on this certificate.

A. Description of original monument and accessories and/or subsequent restoration:

I-13 Cor Common to Secs. 2&3, T45N, R10W & Secs 34&35, T46N, R10W

- 1841 - Original corner was established by William A. Burt. Witnesses:
Cedar 12, N44°E 38 links - Cedar 8, N44°W 12 links.
- 1849 - Witnesses added by William Ives during the subdivision of Town 45 North, Range 10 West:
Cedar 6, S50°E 13 links - Spruce 6, S70°W 44 links.
- 1983 - LCRC, page 319, Luce County corner records. Eino Sainio, P.S. 7873, found 1" and 3/4" iron pipes, 3" plain cedar post, and 3" scribed cedar post. Also found a probable original tamarack line tree 4.30 chains south and stump of possible original cedar bearing tree S50°E 13 links. Witnesses:
5" Cedar, N40°W 13.0' - 7" Cedar, N72°E 5.0' - 6" Cedar, S38°E 12.5' - 7" Cedar, S68°W 21.5'.
- 1990 - LCRC, page 427, Luce County corner records. Neil E. Hill, P.S. 27447, found old 1" pipe and squared cedar post. Found 3/4" pipe laying along side and disregarded. Found record 1983 bearing trees, bearings and distances of first and last BT's appear to be mixed up. Accepted the 1" pipe and witnessed. Witnesses:
MDOT tag and nail in 5" scribed Cedar, N40°W 21.76'
MDOT tag and nail in 7" scribed Cedar, N72°E 4.72'
MDOT tag and nail in 6" Cedar, S32°E 12.41'
MDOT tag and nail in 7" scribed Cedar, S68°W 13.00'


B. Description of corner evidence found and/or method applied in restoring or reestablishing corner:

This corner is being perpetuated as part of the Luce County Remonumentation Program.
 Found a 1" i.d. iron pipe with a threaded top, 1 foot above ground, next to a squared post and all record bearing trees as called for in the above mentioned 1983 and 1990 LCRC's.

C. Description of monument for corner and accessories established to perpetuate locating the position of the corner:

Found a 1" i.d. iron pipe with a threaded top 1 foot above ground at the corner location, next to a squared cedar post.
 Witnesses:

- Nail and MDOT witness tag in side of blazed, scribed 5" Cedar, N40°W 21.76'
- Nail and MDOT witness tag in side of blazed, scribed 7" Cedar, N72°E 4.63'
- Nail and MDOT witness tag in side of blazed, scribed 7" Cedar, S68°W 13.10'
- Nail and MDOT witness tag in side of blazed, scribed 6" Cedar, S32°E 12.39'
- Nail and rusty tag in side of 12" Cedar, S28°E 10.05'

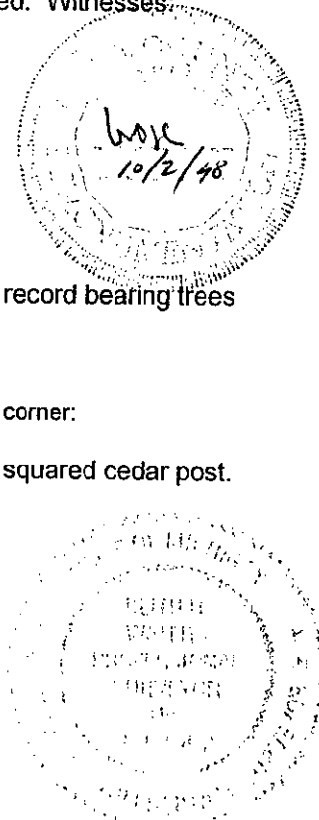

Signed by Keith R. Waters

Date 12-29-98

Surveyor's Michigan License No. 33142