

**LAND CORNER RECORDATION CERTIFICATE**  
**Filing Requirement of Act 74, Mich. P.A. 1970 as Amended**

For corners in

Luce Located In: Corner Code #  
 (County)

1. Public Land Survey T \_\_\_ R \_\_\_  
 T \_\_\_ R \_\_\_  
 T \_\_\_ R \_\_\_  
 S 22 T 45N R 10W 9

2. Property Controlling S 22 T 45N R 10W 11  
 in Section S \_\_\_ T \_\_\_ R \_\_\_

3. Miscellaneous S \_\_\_ T \_\_\_ R \_\_\_  
 Property in Sec. S \_\_\_ T \_\_\_ R \_\_\_

**Register of Deeds Stamp & File Number**

4. Lot No. \_\_\_\_\_, Recorded Plat \_\_\_\_\_  
 5. Private Claims

I, Stephan J. Szyszkoski, in a field survey on July 31, 2007 do hereby state that under requirements of P.A. 74, Michigan P.A. of 1970, the corner points mentioned in lines 1 and 2 above were in conformance with regulations and rules therefore as required in the current manual of survey instructions of the United States Department of the Interior, Bureau of Land Management or by a decree of a Court of Law and /or that the corner points mentioned in lines 3, 4 and 5 above were in conformance with the rules of the Michigan Board of Land Surveyors or by a Decree of a Court of Law; established, re-established, monumented, recovered, found as expressed below:

	A	B	C	D	E	F	G	H	I	J	K	L	M
1													
2	6		5		4		3		2		1		
3													
4	7		8		9		10		11		12		
5													
6	18		17		16		15		14		13		
7													
8	19		20		21		22		23		24		
9													
10	30		29		28		27		26		25		
11													
12	31		32		33		34		35		36		
13													

**NOTE: Not more than 2 corners, all in the same town and range, may be recorded on this certificate.**

A. Description of original monument and accessories and/or subsequent restoration:  
 (9-Sec. 22) East 1/16 corner, Section 22. 1978 - established by Billy D. Buckler RLS in an erroneous position. Found no further record.

(11-Sec. 22) Southwest 1/16 corner, Section 22. 1978 - established by Billy D. Buckler RLS in an erroneous position. Found no further record.


B. Description of corner evidence found and/or method applied in restoring or reestablishing corner:  
 (9-Sec. 22) Established the corner midway and on a straight line between Center of Section 22 1332.46' west and Quarter corner 1332.46' east. From the position thus established, I found the 1978 Buckler monument N89E 9.0' distant and removed it.

(11-Sec. 22) Established the corner at the intersection of straight lines connecting opposite 1/16 corners. From the position thus established, I found the 1978 Buckler monument N23E 23.6' distant and removed it.

C. Description of monument for corner and accessories established to perpetuate locating the position of the corner:  
 (9-Sec. 22) Set 1"IDx36" I.pipe with 4" alum. MDNR cap. Set measuring nails with MDNR tags in:  
 16" Maple N39E 35.02' mrkd "E1/16 BT"  
 9" Maple S45E 22.79' do  
 21" Maple S68W 21.27' do  
 11" Maple N26W 28.69' do  
 Bearings are magnetic. Distances are to nail with tag in side of tree.

(11-Sec. 22) Set 1"IDx36" I.pipe with 4" alum. MDNR cap. Set measuring nails with MDNR tags in:  
 16" Cherry N66E 13.97' mrkd SW1/16 BT"  
 15" Maple N04W 22.92' do  
 5" Maple S36E 18.25' do  
 10" Maple S50W 17.53' do  
 Bearings are magnetic. Distances are to nail and tag in side of tree.

Signed by Stephan J. Szyszkoski

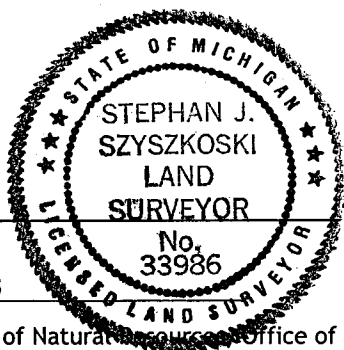

Date 9/11/07

Surveyor's Michigan License No. 33986