

LAND CORNER RECORDATION CERTIFICATE
Filing Requirement of Act 74, Mich. P.A. 1970 as Amended

For corners in

Luce Located In: Corner Code #
 (County)

1. Public Land Survey T ___ R ___
 T ___ R ___
 T ___ R ___
 S 22 T 45N R 10W 12

2. Property Controlling S 28 T 45N R 10W 7
 in Section S ___ T ___ R ___

3. Miscellaneous S ___ T ___ R ___
 Property in Sec. S ___ T ___ R ___

Register of Deeds Stamp & File
 Number

4. Lot No. _____, Recorded Plat _____
 5. Private Claims

7 Jun 05 2007
 12 Jul 30 2007

I, Stephan J. Szyszkoski, in a field survey on _____, 20____ do hereby state that under requirements of P.A. 74, Michigan P.A. of 1970, the corner points mentioned in lines 1 and 2 above were in conformance with regulations and rules therefore as required in the current manual of survey instructions of the United States Department of the Interior, Bureau of Land Management or by a decree of a Court of Law and /or that the corner points mentioned in lines 3, 4 and 5 above were in conformance with the rules of the Michigan Board of Land Surveyors or by a Decree of a Court of Law; established, re-established, monumented, recovered, found as expressed below:

NOTE: Not more than 2 corners, all in the same town and range, may be recorded on this certificate.

A. Description of original monument and accessories and/or subsequent restoration:

(12-Sec. 22) South 1/16 corner Section 22. Not established in the original survey.

(7-Sec. 28) North 1/16 corner between Sections 27 and 28. Not established in the original survey.

B. Description of corner evidence found and/or method applied in restoring or reestablishing corner:

(12-Sec. 22) Established the corner midway and on a straight line between Center of Section 22 1323.82' north and Quarter corner 1323.82' south.

(7-Sec. 28) Established the corner midway and on the Section line between Section corner 1327.00' north and Quarter corner 1327.00' south.

C. Description of monument for corner and accessories established to perpetuate locating the position of the corner:

(12) Set 1"IDx36" I.pipe with 4" alum. MDNR cap.

Set measuring nails with MDNR tags in:

10" Maple S80E 6.9' mrkd "S1/16 BT"

11" Cherry N17E 19.38' do

5" Hemlock N85W 19.46' do

13" Maple S06W 22.7' do

Bearings are magnetic. Distances are to nail with tag in side of tree.

(7-Sec. 28) Set 5/8"x22" rebar with plastic cap,

buried in a N-S road. Set nails with MDNR tags in:

5" Ironwood S34E 76.65' mrkd "N1/16 BT"

12" Maple N83E 61.03' do


Power pole "NY2 37-1" N13W 103.84'

Power pole S18W 139.83'

Bearings are magnetic. Distances are to nail with tag in side of object.

	A	B	C	D	E	F	G	H	I	J	K	L	M
1													
2	6		5		4		3		2		1		
3													
4	7		8		9		10		11		12		
5													
6	18		17		16		15		14		13		
7													
8	19		20		21		22		23		24		
9								●					
10	30		29		28		●	27		26		25	
11													
12	31		32		33		34		35		36		
13													

Signed by Stephan J. Szyszkoski

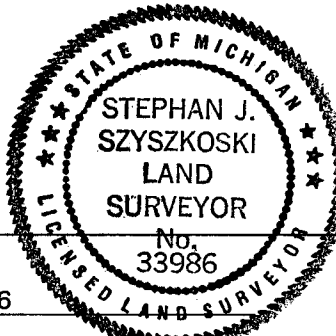

Date 9/11/07

Surveyor's Michigan License No. 33986