


LAND CORNER RECORDATION CERTIFICATE

FILING REQUIREMENT OF ACT 74, MICH. P.A.1970
Luce Co. Two Corners.

FOR CORNERS OF--:	LOCATED IN--:	CORNER CODE NUMBER
1. PUBLIC LAND SURVEY _____	T. <u>45</u> ^{N.} / _{S.} R. <u>11</u> ^{E.} / _{W.}	<u>K-3</u> <u>K-2</u>
2. PROPERTY CONTROLLING IN SECTION _____	, T. _____, N. _____, S. _____, R. _____, E. _____, W. _____	_____
3. MISCELLANEOUS PROPERTY IN SECTION _____	, T. _____, N. _____, S. _____, R. _____, E. _____, W. _____	_____
4. LOT NO. _____, RECORDED PLAT _____	_____	_____
5. PRIVATE CLAIMS _____	_____	_____

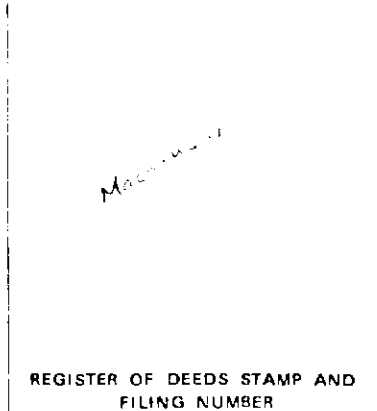

I, Billy D. Buckler do hereby certify that under requirements of P.A. 74, Michigan P.A. of 1970, the corner points mentioned in lines 1 and 2 above (identified with circles on index code diagram - over) were, in a field survey on 5-16-1974, established, re-established, monumented, re-monumented, recovered or restored as expressed below and in conformance with regulations and rules therefore as required in the current manual of survey instructions of the United States Department of the Interior, Bureau of Land Management or by a decree of a court of law. Furthermore, that the corner points mentioned in lines 3, 4 and 5 above were, in a field survey on _____ 19____, found, recovered, restored, established or re-established as expressed below and in conformance with the rules of the Michigan State Board of Registration for Land Surveyors or, by a Decree of a Court of law:

A. Description of original monument and accessories and/or subsequent restoration:

Corners were set by William Ives, D.S. in 1849.
 K-3 Section Corner 1-2-11-12.
 Bearings were: Sugar 12, N17°W, 40 lks. and Sugar 14, S23°E, 51 lks.
 K-2 Quarter Corner bet. Sec's 1-2.
 Bearings were: Sugar 7, N45°W, 12 lks. and Beech 7, S34°E, 6 lks.


B. Description of corner evidence found and/or method applied in restoring or re-establishing corner:

K-3 Found 3/4" Iron standing 5" above ground. Believe this corner to have been set by M.S.H.D. Found trees blazed as witnesses about 1967.
 K-2 Re-established corner 140' South of an old East-West fence and 2640' North of Sec. Cor. 1-2-11-12. Distance North to swamp cheks well. No other evidence.

C. Description of monument for corner and accessories established to perpetuate locating the position of the corner:

K-3 Recorded corner as we found it.
 Bearings: 8" Ironwood, S70°E, 27.5' and 10" H. Maple, N50°W, 41.0'
 Corner lies 150' North of old grade and 48' West of a woods trail.
 K-2 Placed 1" pipe with 4" aluminium cap at corner.
 Bearings: 9" Balsam, S14°E, 27.0' and 8" Balsam, S45°W, 36.0' and
 9" Balsam, N51°E, 12.5'

SIGNED BY Billy D. Buckler DATE 4-7-75
 SURVEYOR'S MICHIGAN REGISTRATION NO. 8887

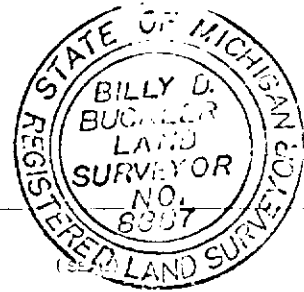

FOR STATE AND UNITED STATES AGENCIES:
 SIGNED BY _____ DATE _____
CHIEF OF SURVEY PARTY
 APPROVED AND SIGNED BY _____ DATE _____
MICHIGAN REGISTERED LAND SURVEYOR

SURVEYOR'S MICHIGAN REGISTRATION NO. _____