

MICHIGAN
DEPARTMENT OF CONSERVATION
FORESTRY DIVISION

LAND CORNER RECORD

T. 45N N.R. 11W


Luce COUNTY

DESCRIPTION OF CORNER West 1/16 Corner bet. Secs. 15-22

CORNER MONUMENT 1" pipe with 4" aluminum cap, buried in north edge of road.

DATE MONUMENT PLACED AND WITNESSED 8-27-69

WITNESSES TO CORNER..... 9" Hard Maple (1/16 BT) N12°E 6.6'

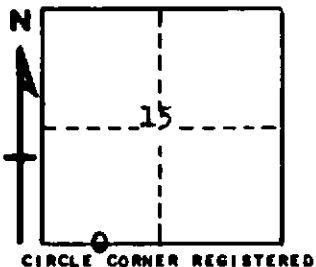

9" Hard Maple (1/16 BT) N64°W 14.4'

AND

DESCRIPTION IN DETAIL AS TO HOW CORNER WAS LOCATED AND IDENTIFIED OR RESTORED.

This corner placed midway and on line bet. Sec. Cor. to west and $\frac{1}{4}$ Cor. to east.

SURVEYOR'S SEAL

SIGNED *Billy D. Buckler*
Billy D. Buckler DATE 3-6-70
REGISTERED LAND SURVEYOR