

SURVEY & REMONUMENTATION

MAY 28 1997

COMMISSION

LUCE COUNTY REMONUMENTATION CORNER

LAND CORNER RECORDATION CERTIFICATE
Filing Requirement of Act 74, Mich. P.A. 1970

LUCE COUNTY REGISTER OF DEEDS

Recorded
Liber 2 Page 729
02-28-1997 08:57:38
Kathy S. Maha
KATHA S. MAHA, Registrar
REGISTER OF DEEDS

For corners in


<u>Luce</u> (County)	Located In:	Corner Code #
1. Public Land Survey	T.45N R.11W	<u>A-2</u> Same
	T.45N R.12W	M-2 Corner
	T. R.	
	T. R.	
2. Property Controlling in Section	S. T. R.	
	S. T. R.	
3. Miscellaneous Property in Sec.	S. T. R.	
	S. T. R.	

Register of Deeds Stamp & File Number

4. Lot No. _____, Recorded Plat _____
5. Private Claims _____

I, William L. Karr, in a field survey on Dec. 13, 1996 do hereby state that under requirements of P.A. 74, Michigan P.A. of 1970, the corner points mentioned in lines 1 and 2 above were in conformance with regulations and rules therefore as required in the current manual of survey instructions of the United States Department of the Interior, Bureau of Land Management or by a decree of a Court of Law and /or that the corner points mentioned in lines 3, 4 and 5 above were in conformance with the rules of the Michigan Board of Land Surveyors or by a Decree of a Court of Law, established, re-established, monumented, recovered, found as expressed below:

NOTE: Not more than 2 corners, all in the same town and range, may be recorded on this certificate.

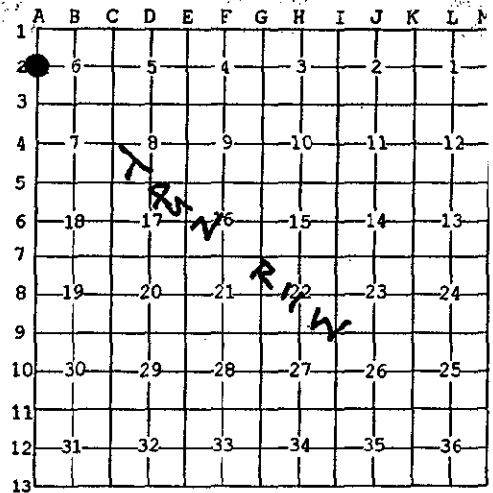

A. Description of original monument and accessories and/or subsequent restoration:

(A-2) 1/4 Corner Common to Section 6, T.45 N., R.11 W., and Section 1, T.45 N., R.12 W.
1841: J. Burt for W.A. Burt set post Cedar 7 N5°E 38
Cedar 10 N15°W 12



B. Description of corner evidence found and/or method applied in restoring or reestablishing corner:


(A-2) This Corner is being re-established as part of the Luce County Remonumentation Program.

Found no evidence of original corner. Re-established corner by single proportionate measurement between the Township corner to the North and 1/4 corner 7 & 12 to the South. Distance South is 5274.44' (G.L.O. is 5280'); distance to the North is 2594.36' (G.L.O. is 2597.10').

C. Description of monument for corner and accessories established to perpetuate locating the position of the corner:

(A-2) Corner is a 1/2" x 24" iron with stamped aluminum Luce County Remonumentation cap.

Witnesses:	14" Cedar	N08°E	24.13'
	14" Spruce	S73°E	23.00'
	6" Cedar	S20°W	15.39'
	8" Cedar	N58°W	24.97'

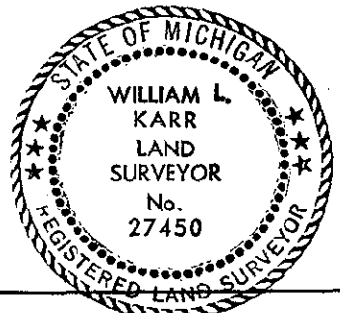

Signed by William L. Karr
Surveyor's Michigan License No. 27450

Date 12-30-96

NOTE: All bearings are ~~compass bearings corrected~~ for declination. All distances are to a nail in side of witness objects unless noted.