


**SURVEY &
REMONUMENTATION**

LAND CORNER RECORDATION CERTIFICATE
APR 07 1998 Filing Requirement of Act 74, Mich. P.A. 1970
 Luce County Remonumentation Corner

corners in
 Luce County SECTION
 Located in: Corner Code #
 Public Land Survey T45N R11W B-5
 T R
 T R
 T R
 Property Controlling S T R
 in Section S T R
 Miscellaneous S T R
 Property in Sec. S T R
 Lot No. , Recorded Plat
 Private Claims

LUCE COUNTY
 REGISTER OF DEEDS
 Recorded
Liber 3 page 764
 02-24-1998 14:44:20
Karen R. Wendt Dep
 Kathy S. Mahar, Register
 REGISTER OF DEEDS
 Register of Deeds Stamp & File Number

William L. Karr, in a field survey on December 12, 1997, do hereby state that under requirements of P.A. 74, Michigan P.A. of 1970, the corner points mentioned in lines 1 and 2 above were in conformance with regulations and rules therefore as required in the current manual of survey instructions of the United States Department of the Interior, Bureau of Land Management or by a decree of a Court of Law and /or that the corner points mentioned in lines 3, 4 and 5 above were in conformance with the rules of the Michigan Board of Land Surveyors or by a Decree of a Court of Law; established, re-established, monumented, recovered, found as expressed below:

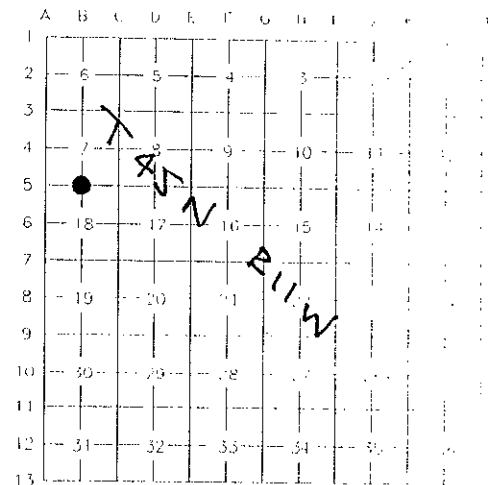

NOTE: Not more than 2 corners, all in the same town and range, may be recorded on this certificate.

Description of original monument and accessories and/or subsequent restoration:

(B-5) 1/4 Corner Common to Sections 7 and 18, T. 45 N., R. 11 W.

1849 William Ives set post in original survey.

Witnesses: B. Ash N 35°E 38 lks
 B. Ash S 45° W 12 lks

Early 1900's Township sketch from MDNR office shows this to have been a corner perpetuated by Harold Lawrence.

1969 Tressler's North Shore Plat, recorded pg. 37 of Luce County Plats, surveyed by Eino Sainio P.S. 7873 shows 1/4 corner.

1997 Discussion with Eino Sainio, he remembered finding square scribed post set by Lawrence along with remains of original evidence when doing the plat in 1969.

Description of corner evidence found and/or method applied in restoring or reestablishing corner:

(B-5) 1/4 Corner Common to Sections 7 and 18, T. 45 N., R. 11 W.

This corner is being perpetuated as part of the Luce County Remonumentation Program.

Found old scribed square cedar post set by Lawrence and used by Sainio. Distance to section corner to West measures 13.4' longer than GLO. Accepted post for 1/4 corner and replaced with a 1/2" iron and cap.




Description of monument for corner and accessories established to perpetuate locating the position of the corner:

(B-5) 1/4 Corner Common to Sections 7 and 18, T. 45 N., R. 11 W.

Corner is a 1/2" x 48" re-bar with a stamped aluminum Luce County Remonumentation cap.

Witnesses: Steel Fence Post North 1.00'
 10" Cedar North 20.05'
 8" Cedar S 64° E 11.92'
 6" Cedar S 42° W 12.76'
 5" Cedar West 18.89'

 

Bearings are compass bearings, corrected for declination (6°W), all distances are to a nail and tag in the side of the witness object unless otherwise noted.

Signed by *William L. Karr*

Date *12/12/97*

Surveyor's Michigan License No. 27450