

888 1-9 1999

**LAND CORNER RECORDATION CERTIFICATE**  
**Filing Requirement of Act 74, Mich. P.A. 1970**  
Luce County Remonumentation Corner


For corners in **SECTION**

Luce County	Located in:	Corner Code #
1. Public Land Survey	T45N R11W	C-12
	T R	
	T R	
	T R	
2. Property Controlling in Section	S T R	
	S T R	
3. Miscellaneous Property in Sec.	S T R	
	S T R	
4. Lot No.	Recorded Plat	
5. Private Claims		

LUCE COUNTY  
REGISTER OF DEEDS  
Recorded  
*Liber 3 page 844*  
01-20-1999 15:05:00  
*Karen R Wendell Reg*  
Kathy S. Mahar, Register  
REGISTER OF DEEDS

Register of Deeds Stamp & File Number

	A	B	C	D	E	F	G	H	I	J	K	L	M
1													
2	6		5		4		3		2				
3													
4	7		8		9		10		11				
5													
6	18		17		16		15		14				
7													
8	19		20		21		22		23				
9													
10	30		29		28		27		26				
11													
12	31		32		33		34		35				
13													

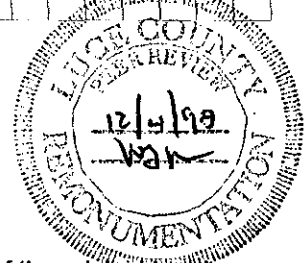

I, William L. Karr, in a field survey on December 7, 1998, do hereby state that under requirements of P.A. 74, Michigan P.A. of 1970, the corner points mentioned in lines 1 and 2 above were in conformance with regulations and rules therefore as required in the current manual of survey instructions of the United States Department of the Interior, Bureau of Land Management or by a decree of a Court of Law and /or that the corner points mentioned in lines 3, 4 and 5 above were in conformance with the rules of the Michigan Board of Land Surveyors or by a Decree of a Court of Law, established, re-established, monumented, recovered, found as expressed below:

NOTE: Not more than 2 corners, all in the same town and range, may be recorded on this certificate.

A. Description of original monument and accessories and/or subsequent restoration:

(C-12) 1/4 Corner Common to Sections 31 and 32, T. 45 N., R. 11 W.

1849 Wm. Ives set a post for the corner in the original survey.  
Witnesses: 10" Cedar N 65° E 22 lks  
12" Cedar S 35° W 18 lks

1950 G.A. Shadko, P.S. 1934, found a cedar post set by H.A. Lawrence and the rotted stumps of the original bearing trees. Shadko remonumented the corner with a 3" pipe with a stamped brass cap and new witnesses.

1984 Eino Sanio, P.S. 7873, in a survey recorded in L.1, P. 76, Luce County Surveys, shows the 1/4 corner 1111.4' East of the West R.O.W. of M-135.

B. Description of corner evidence found and/or method applied in restoring or reestablishing corner:

(C-12) 1/4 Corner Common to Sections 31 and 32, T. 45 N., R. 11 W.

This corner is being perpetuated as part of the Luce County Remonumentation Program.

Recovered the corner as monumented by Shadko in 1950. There is no longer any evidence of the original witnesses and the witnesses established by Shadko are in poor condition.  
Accepted the position as recovered and established new witnesses.

C. Description of monument for corner and accessories established to perpetuate locating the position of the corner:

(C-12) 1/4 Corner Common to Sections 31 and 32, T. 45 N., R. 11 W.

Corner is a 3" pipe with a stamped brass cap.  
Witnesses: Cedar Post East 1.0'  
Cedar 8" N 42° E 22.08'  
Cedar 14" S 60° E 25.10'  
Ash 6" S 62° W 21.86'  
White Birch 8" N 88° W 25.33'

Bearings are compass bearings, corrected for declination, all distances are to a nail and tag in the side of the witness object unless otherwise noted.



Signed by William L. Karr

Date 12/24/98

Surveyor's Michigan License No. 27450