

1993

Luce County Remonumentation Program

COMMISSION

LAND CORNER RECORDATION CERTIFICATE
Filing Requirement of Act 74, Mich. P.A. 1970

For corners in

Form with fields for Luce (County), Located In: (Township and Range), Corner Code #, and numbered sections 1-5 for describing the survey.

Filed 12-22 A.D., 1993
At 10:00 o'clock A.M.
Liber 2
File No. page 536
Kathy S. Mahon
Luce County Reg. of Deeds
Register of Deeds Stamp & File Number

I, William L. Karr, in a field survey on October 20, 1993, do hereby certify that under requirements of P.A. 74, Michigan P.A. of 1970, the corner points mentioned in lines 1 and 2 above were in conformance with regulations and rules therefore as required in the current manual of survey instructions of the United States Department of the Interior, Bureau of Land Management or by a decree of a Court of Law and/or that the corner points mentioned in lines 3, 4 and 5 above were in conformance with the rules of the Michigan Board of Land Surveyors or by a Decree of a Court of Law; established, re-established, monumented, re-monumented, recovered, found as expressed below:

NOTE: Not more than 4 corners, all in the same town and range, may be recorded on this certificate.

Grid table with columns A-M and rows 2-13, containing numbers 1-36 and a small circle in cell A13.

A. Description of original monument and accessories and/or subsequent restoration:

(C-13) Section Corner Sections 31 & 32, T45N-R11W and Sections 5 & 6, T44N-R11W (Township Line and County Line)

- 1841: Corner established by John Burt for William A. Burt
1973: Franklyn T. Burgess, L.S. 2531. Survey recorded in L.1-P.6 of Luce County Survey records. Calls for brass capped State Conservation Department monument. N 04 E 20.1 U.S.G.S. monument, N 89-27 W 33.3' to centerline.
1978: Thomas O'Brien, L.S. 21274. Corner recorded in L.B-P.092 of Mackinac County Corner Records. Found pointed iron bar.
Power Pole N 38-05 E - 58.8'
Power Pole N 65-50 W - 101.4'


B. Description of corner evidence found and/or method applied in restoring or reestablishing corner:

Corner perpetuated as part of the Luce County Remonumentation Program. Found a 3/4" iron with a pointed top. Off-set iron and found a Michigan Conservation Department monument with a 3 1/2" diameter stamped brass cap (Not all stamping legible), 10" below gravel road surface. Found a 1/4" iron in concrete N02°E-19.63'. Did not find the two power poles as called for on O'Brien's Corner Recordation Certificate. Accepted Michigan Conservation Department monument as corner position.

C. Description of monument for corner and accessories established to perpetuate locating the position of the corner:

Corner is a Michigan Conservation Department monument with a 3 1/2" diameter stamped brass cap (not all stamping legible), 10" below gravel road surface. Falls 5' North of the centerline of Luce County Road 473 to the East (East-West, gravel). Falls 33' East of the centerline of H-33 (along curve, paved). Falls on extension of centerline of H-33 to the South.

- 1/4" Iron in Concrete N02°E 19.63'
Power Pole NY3/167/66 S45°E 45.01'
Apple Tree S22°W 151.51'
Cut-Off Power Pole S60°W 65.51'
"V" Notch in Southerly End of 15" C.M.P. N34°W 178.74'

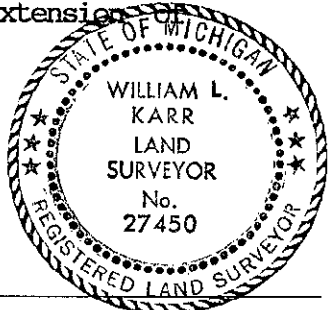

Signed by William L. Karr Date 12/16/93

Surveyor's Michigan License No. 27450

NOTE: Bearings are compass bearings corrected for declination. Distances are to a nail with P.S. 27450 tag in side of witness objects unless noted.