

MAY 28 1997

COMMISSION

LUCE COUNTY REMONUMENTATION CORNER

LAND CORNER RECORDATION CERTIFICATE  
Filing Requirement of Act 74, Mich. P.A. 1970

LUCE COUNTY  
REGISTER OF DEEDS  
Recorded

*Liber 2 Page 734*  
02-28-1997 08:58:25  
*Kathy S. Maha*  
Kathy S. Maha, Register  
REGISTER OF DEEDS

For corners in  
Luce

(County)

Located In:

Corner Code #

1. Public Land Survey

T45N R11W E-1 Same  
T46N R11W E-13 Corner

2. Property Controlling  
in Section

S T R  
S T R


3. Miscellaneous  
Property in Sec.

S T R  
S T R

4. Lot No. \_\_\_\_\_, Recorded Plat \_\_\_\_\_  
5. Private Claims \_\_\_\_\_

I, William L. Karr, in a field survey on Dec. 9, 1996 do hereby state that under requirements of P.A. 74, Michigan P.A. of 1970, the corner points mentioned in lines 1 and 2 above were in conformance with regulations and rules therefore as required in the current manual of survey instructions of the United States Department of the Interior, Bureau of Land Management or by a decree of a Court of Law and /or that the corner points mentioned in lines 3, 4 and 5 above were in conformance with the rules of the Michigan Board of Land Surveyors or by a Decree of a Court of Law; established, re-established, monumented, recovered, found as expressed below:

NOTE: Not more than 2 corners, all in the same town and range, may be recorded on this certificate.

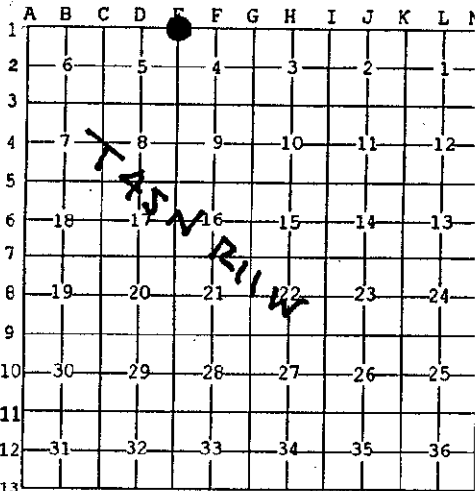

A. Description of original monument and accessories and/or subsequent restoration:

(E-1) Section Corner Common to Sections 4 & 5, T.45 N., R.11 W., and Sections 32 & 33, T.46 N., R.11 W.  
1841: W.A. Burt set post Beech 6 N21°E 16  
Beech 14 N70°W 22  
1994: W.L. Karr set 1/2" x 48" iron with cap No. 27450 at fence corner to East and South.  
(4) witnesses were established.

B. Description of corner evidence found and/or method applied in restoring or reestablishing corner:

(E-1) This Corner is being perpetuated as part of the Luce County Remonumentation Program.  
Found no evidence of original corner. Found corner set in 1994 survey and (2) witness trees. Recent logging operation had removed (2) trees. Distance East to 1/4 corner 4/33 is 2640.07'; distance West to Section Corner 5, 61 31 & 32 is 5293.66'. Accepted corner position as found.

C. Description of monument for corner and accessories established to perpetuate locating the position of the corner:

(E-1) Corner is a 1/2" x 48" iron with cap No. 27450 at base of large squared post.

Witnesses: 8" Maple N53°E 4.68'  
10" Maple S08°W 24.91'  
9" Maple N85°W 34.85'  
5" Maple N32°W 25.58'

Signed by William L. Karr  
Surveyor's Michigan License No. 27450

Date 12-30-96

