

**SURVEY &  
REMONUMENTATION LAND CORNER RECORDATION CERTIFICATE**

Filing Requirement of Act 74, Mich. P.A. 1970

APR 07 1998

Luce County Remonumentation Corner

For corners in

Luce County

SECTION located in:

Corner Code #


- |                                       |   |      |      |     |
|---------------------------------------|---|------|------|-----|
| 1. Public Land Survey                 |   | T45N | R11W | E-2 |
|                                       |   | T    | R    |     |
|                                       |   | T    | R    |     |
|                                       |   | T    | R    |     |
| 2. Property Controlling<br>in Section | S | T    | R    |     |
|                                       | S | T    | R    |     |
| 3. Miscellaneous<br>Property in Sec.  | S | T    | R    |     |
|                                       | S | T    | R    |     |

4. Lot No. , Recorded Plat  
5. Private Claims

LUCE COUNTY  
REGISTER OF DEEDS  
Recorded

*liber 3 page 771*  
02-24-1998 14:45:36  
*Hauer R. Wendt Dep*  
Kathy S. Mahar, Register  
REGISTER OF DEEDS

Register of Deeds Stamp & File Number

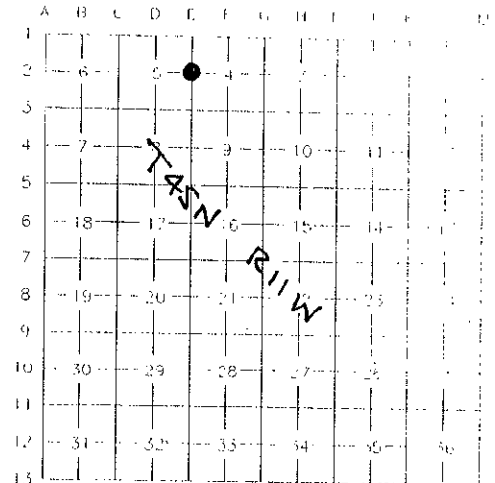

I, William L. Karr, in a field survey on December 19, 1997, do hereby state that under requirements of P.A. 74, Michigan P.A. of 1970, the corner points mentioned in lines 1 and 2 above were in conformance with regulations and rules therefore as required in the current manual of survey instructions of the United States Department of the Interior, Bureau of Land Management or by a decree of a Court of Law and /or that the corner points mentioned in lines 3, 4 and 5 above were in conformance with the rules of the Michigan Board of Land Surveyors or by a Decree of a Court of Law; established, re-established, monumented, recovered, found as expressed below:

NOTE: Not more than 2 corners, all in the same town and range, may be recorded on this certificate.

A. Description of original monument and accessories and/or subsequent restoration:

(E-2) 1/4 Corner Common to Sections 4 and 5, T. 45 N., R. 11 W.

1845 William Ives set post in original survey.

Witnesses:	6" Beech	N 60° W	13 lks
	8" Beech	S 60° E	5 lks

Could find no subsequent survey history on this corner in available public records.

B. Description of corner evidence found and/or method applied in restoring or reestablishing corner:

(E-2) 1/4 Corner Common to Sections 4 and 5, T. 45 N., R. 11 W.

This corner is being perpetuated as part of the Luce County Remonumentation Program.

Found no evidence of the original corner or subsequent restoration.

Found a fence corner with fences running East and South, 53.6' South and 70.3' East of prorated position between the section corners to the North and South. The fence corner does not work with either the prorated position or an even split between the section corners and did not accept it as evidence of the corner position.

Reestablished the 1/4 corner by proportionate measurement between the section corner North, 2546.76' (GLO), 2529.33' (meas) and South, 2640' (GLO), 2621.94' (meas).

C. Description of monument for corner and accessories established to perpetuate locating the position of the corner:

(E-2) 1/4 Corner Common to Sections 4 and 5, T. 45 N., R. 11 W.

Corner is a 1/2" x 24" re-bar with a stamped aluminum Luce County Remonumentation cap.

Witnesses:	14" Maple	N 03° E	38.77'
	12" Maple	N 58° E	23.38'
	14" Maple	S 21° E	9.23'
	12" Maple	West	1.57'
	Fence Corner	S 54° E	88.4'

Bearings are compass bearings, corrected for declination (6°W), all distances are to a nail and tag in the side of the witness object unless otherwise noted.

Signed by *William L. Karr*

Date *12/19/97*

Surveyor's Michigan License No. 27450