

SURVEY & REMONUMENTATION

LUCe COUNTY REMONUMENTATION CORNER

APR 28 1995

LAND CORNER RECORDATION CERTIFICATE

Filing Requirement of Act 74, Mich. P.A. 1970

For corners **COMMISSION**


Luce <small>(County)</small>	Located In:	Corner Code #	
1. Public Land Survey	T <u>45N</u> R <u>11W</u>	<u>E-5</u>	
	T _____ R _____	_____	
	T _____ R _____	_____	
	T _____ R _____	_____	
2. Property Controlling in Section	S _____ T _____ R _____	_____	
	S _____ T _____ R _____	_____	
3. Miscellaneous Property in Sec.	S _____ T _____ R _____	_____	
	S _____ T _____ R _____	_____	

Filed 1/20 A.D., 1995
 At 12:30 o'clock P.M.
Liber 2
 File No. page 585
Kathy S. Mahan
 Luce County Reg. of Deeds

Register of Deeds Stamp & File Number

4. Lot No. _____, Recorded Plat _____
 5. Private Claims _____

I, William L. Karr, in a field survey on December 13, 1994, do hereby certify that under requirements of P.A. 74, Michigan P.A. of 1970, the corner points mentioned in lines 1 and 2 above were in conformance with regulations and rules therefore as required in the current manual of survey instructions of the United States Department of the Interior, Bureau of Land Management or by a decree of a Court of Law and/or that the corner points mentioned in lines 3, 4 and 5 above were in conformance with the rules of the Michigan Board of Land Surveyors or by a Decree of a Court of Law; established, re-established, monumented, re-monumented, recovered, found as expressed below:

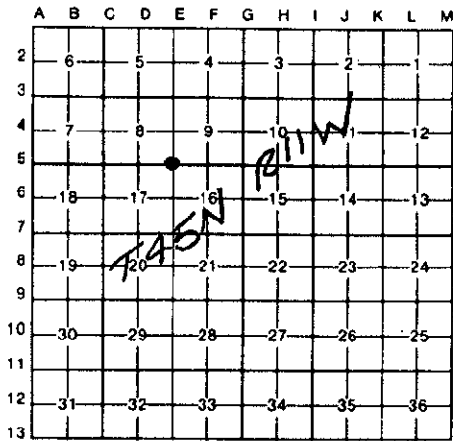


NOTE: Not more than 4 corners, all in the same town and range, may be recorded on this certificate.

A. Description of original monument and accessories and/or subsequent restoration:

- (E-5) Section Corner 8, 9, 16 & 17, T.45 N., R.11 W.
1849: W. Ives set post 8" Beech S48E 31 lks
 6" Beech N20W 33 lks
Undated: Old State Hwy plans for abandoned M-28 show distances North & West to the 1/4 corners.
1983: E. Sanio (P.S. 7873) recorded corner in L.1, P.318 of corner records.
 Found a 1-1/4" pipe probably set by J.V. Kinsey, County Surveyor in the early 1930's. 5" H. Maple N62E 18.5' 9" H. Maple S40W 28.3'
 9" H. Maple S50E 10.9' 9" H. Maple N60W 25.5'

B. Description of corner evidence found and/or method applied in restoring or reestablishing corner:

(E-5) This corner is being perpetuated as part of the Luce County Remonumentation program. Found a 1-3/4" O.D. pipe and (4) recorded, scribed bearing trees. Also 1/2 mile distances North and West matched old Hwy distances: (North 2657.08'- Hwy, 2655.40'- today; West 2681.57'- Hwy, 2682.51'- today). Accepted corner position as found.

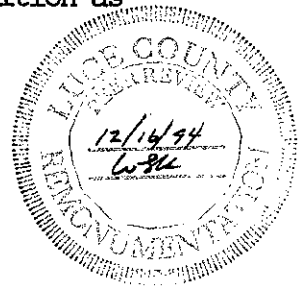

C. Description of monument for corner and accessories established to perpetuate locating the position of the corner:

(E-5) Corner is a 1-3/4" pipe, 24" above ground and leaning slightly to the West but firmly in the ground.

Witnesses: 6" Maple (existing-added nail)	N57°E 18.49'
10" Maple (existing-added nail)	S55°E 11.43'
8" Maple (existing-added nail)	S38°W 28.45'
12" Maple (existing-added nail)	N61°W 25.84'



Signed by William L. Karr Date 12/22/94

Surveyor's Michigan License No. 27450

NOTE: Bearings are compass bearings corrected for declination.
 Distances are to a nail in side of witness objects unless noted.