

**SURVEY &
REMONUMENTATION**

APR 07 1998


**LAND CORNER RECORDATION CERTIFICATE
Filing Requirement of Act 74, Mich. P.A. 1970
Luce County Remonumentation Corner**

For corners in **SECTION**

Luce County	Located in:	Corner Code #
1. Public Land Survey	T45N R11W E-8	
	T R	
	T R	
	T R	
2. Property Controlling in Section	S T R	
	S T R	
3. Miscellaneous Property in Sec.	S T R	
	S T R	
4. Lot No.	Recorded Plat	
5. Private Claims		

LUCE COUNTY
REGISTER OF DEEDS
Recorded
Liber 3 page 774
02-24-1998 14:46:10
Karen R. Wenzel Dip
Kathy S. Mahar, Register
REGISTER OF DEEDS

Register of Deeds Stamp & File Number

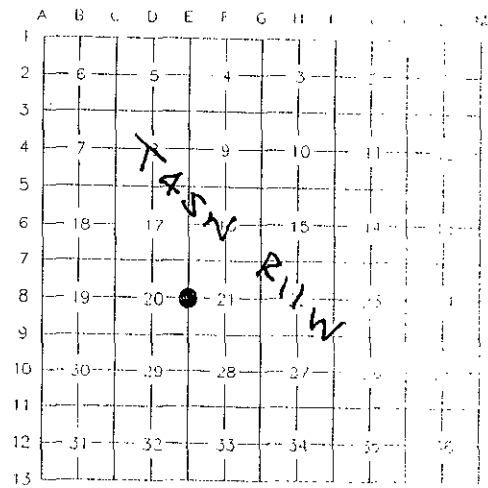

I, William L. Karr, in a field survey on December 12, 1997, do hereby state that under requirements of P.A. 74, Michigan P.A. of 1970, the corner points mentioned in lines 1 and 2 above were in conformance with regulations and rules therefore as required in the current manual of survey instructions of the United States Department of the Interior, Bureau of Land Management or by a decree of a Court of Law and /or that the corner points mentioned in lines 3, 4 and 5 above were in conformance with the rules of the Michigan Board of Land Surveyors or by a Decree of a Court of Law; established, re-established, monumented, recovered, found as expressed below:

NOTE: Not more than 2 corners, all in the same town and range, may be recorded on this certificate.

A. Description of original monument and accessories and/or subsequent restoration:

(E-8) 1/4 Corner Common to Sections 20 and 21, T. 45 N., R. 11 W.

1849 William Ives set post in original survey.
Witnesses: 8" Cedar N 31° W 19 lks
7" Fir S 25° E 14 lks

1975 Billy Buckler P.S. 8887 recorded corner, page 275 Luce County corner records. Reestablished position from one possible original BT stump and set a 1" pipe with a 4" aluminum cap.
Witnesses: 9" Cedar S 44° E 26.8'
6" W. Spruce N 25° E 1.6'

B. Description of corner evidence found and/or method applied in restoring or reestablishing corner:

(E-8) 1/4 Corner Common to Sections 20 and 21, T. 45 N., R. 11 W.
This corner is being perpetuated as part of the Luce County Remonumentation Program.
Found pipe with cap and witnesses established by Buckler in 1975.
Accepted the pipe with cap for 1/4 corner.




C. Description of monument for corner and accessories established to perpetuate locating the position of the corner:

(E-8) 1/4 Corner Common to Sections 20 and 21, T. 45 N., R. 11 W.

Corner is a 1" pipe with a stamped aluminum DNR cap. The corner falls in wooded area 12.5' West of centerline of a road into a hunting camp.

Witnesses: 9" Spruce N 37° E 1.99'
12" White Birch S 60° E 37.11'
12" White Birch N 41° W 14.78'
6" Spruce N 22° W 14.57'

 

Bearings are compass bearings, corrected for declination (6°W), all distances are to a nail and tag in the side of the witness object unless otherwise noted.

Signed by William L. Karr Date 12/12/97

Surveyor's Michigan License No. 27450