

SURVEY & REMONUMENTATION

APR 28 1995

LUCÉ COUNTY REMONUMENTATION CORNER LAND CORNER RECORDATION CERTIFICATE Filing Requirement of Act 74, Mich. P.A. 1970

COMMISSION

For corners in

Luce <small>(County)</small>	Located In:	Corner Code #	
1. Public Land Survey	T <u>45N</u> R <u>11W</u>	<u>E-9</u>	
	T _____ R _____	_____	
	T _____ R _____	_____	
	T _____ R _____	_____	
2. Property Controlling in Section	S _____ T _____ R _____	_____	
	S _____ T _____ R _____	_____	
3. Miscellaneous Property in Sec.	S _____ T _____ R _____	_____	
	S _____ T _____ R _____	_____	
4. Lot No. _____, Recorded Plat _____			
5. Private Claims _____			

Filed 1/20 A.D., 1995


At 12:30 o'clock P. M.

Liber 2
File No. page 584

Kathy S. Waka
Luce County Reg. of Deeds

Register of Deeds Stamp & File Number

I, William L. Karr, in a field survey on December 07, 1994, do hereby certify that under requirements of P.A. 74, Michigan P.A. of 1970, the corner points mentioned in lines 1 and 2 above were in conformance with regulations and rules therefore as required in the current manual of survey instructions of the United States Department of the Interior, Bureau of Land Management or by a decree of a Court of Law and/or that the corner points mentioned in lines 3, 4 and 5 above were in conformance with the rules of the Michigan Board of Land Surveyors or by a Decree of a Court of Law; established, re-established, monumented, re-monumented, recovered, found as expressed below:

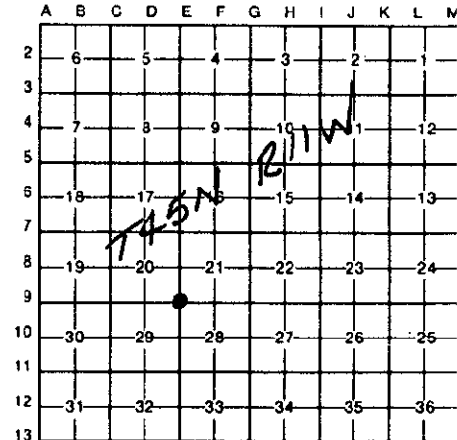

NOTE: Not more than 4 corners, all in the same town and range, may be recorded on this certificate.

A. Description of original monument and accessories and/or subsequent restoration:
(E-9) Section Corner 20, 21, 28 & 29, T.45 N., R.11 W.

1849: W. Ives set post 6" Cedar S42W 20 lks
5" Spruce N54E 14 lks

1975: Billy D. Buckler, P.S. 8887 (DNR) (Pg.275 of Corner Records) replaced corner at a wood stake set by unknown surveyor. Distance from section corner one mile North = 5279.2. Placed 1" pipe with 4" aluminum cap.
New Bearing trees:

8" Tamarack	S76°E	32.6'
10" W. Pine	N77°W	34.0'

B. Description of corner evidence found and/or method applied in restoring or reestablishing corner:

(E-9) This corner is being perpetuated as part of the Luce County Remonumentation program.

Found 1" pipe with aluminum DNR cap and 2 record Bearing trees. (Tamarack to Southeast - possibly a spruce).

Accepted corner position as found and added two additional Bearing trees.



C. Description of monument for corner and accessories established to perpetuate locating the position of the corner:

(E-9) Corner is a 1" pipe with aluminum DNR cap, 12" above ground. There is a 6" square wood post (5' tall) next to it. Corner falls in a small clear area.

Witnesses: 6" Spruce	N04°W	24.96'
12" Spruce (Existing-Added Nail)	S75°E	33.06'
10" Cedar	S10°W	19.53'
14" W. Pine (Existing- Added Nail)	N80°W	34.02'



Signed by William L. Karr Date 12/22/94

Surveyor's Michigan License No. 27450

NOTE: Bearings are compass bearings corrected for declination.
Distances are to a nail in side of witness objects unless noted.