

SURVEY & REMONUMENTATION

LUCE COUNTY REMONUMENTATION CORNER

APR 28 1995

LAND CORNER RECORDATION CERTIFICATE

Filing Requirement of Act 74, Mich. P.A. 1970

For corners to **COMMISSION**


Luce <small>(County)</small>	Located In:	Corner Code #	
1. Public Land Survey	T <u>45N</u> R <u>11W</u>	<u>E-10</u>	
	T _____ R _____	_____	
	T _____ R _____	_____	
	T _____ R _____	_____	
2. Property Controlling in Section	S _____ T _____ R _____	_____	
	S _____ T _____ R _____	_____	
3. Miscellaneous Property in Sec.	S _____ T _____ R _____	_____	
	S _____ T _____ R _____	_____	

Filed 1/20 A.D., 19 95
At 12:30 o'clock P. M.
Liber 2
File No. page 587
Kathy S. Maha
Luce County Reg. of Deeds

Register of Deeds Stamp & File Number

4. Lot No. _____, Recorded Plat _____
5. Private Claims _____

I, William L. Karr, in a field survey on December 21, 19 94, do hereby certify that under requirements of P.A. 74, Michigan P.A. of 1970, the corner points mentioned in lines 1 and 2 above were in conformance with regulations and rules therefore as required in the current manual of survey instructions of the United States Department of the Interior, Bureau of Land Management or by a decree of a Court of Law and/or that the corner points mentioned in lines 3, 4 and 5 above were in conformance with the rules of the Michigan Board of Land Surveyors or by a Decree of a Court of Law; established, re-established, monumented, re-monumented, recovered, found as expressed below:

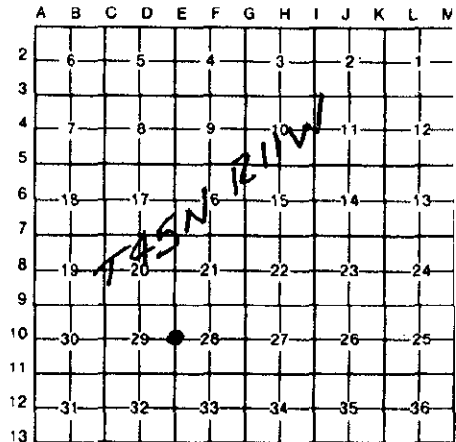

NOTE: Not more than 4 corners, all in the same town and range, may be recorded on this certificate.

A. Description of original monument and accessories and/or subsequent restoration:
(E-10) 1/4 Corner 29 & 28, T.45 N., R.11 W.
1849: W. Ives set post

6" Fir N82°E 11 lks
7" Beech S60°W 27 lks



B. Description of corner evidence found and/or method applied in restoring or reestablishing corner:
(E-10) This corner is being re-established as part of the Luce County Remonumentation program.
In talking with Eino Sanio, P.S. 7873, He said that years ago, he had re-established a position on this corner and had scribed Bearing trees. He thought he may have re-established by single proportionate measurement. He could not find his information on this corner as he had been part way into the project when it had been canceled. Found the 2 scribed Bearing trees by Sanio, and also a fallen fenceline to the East and a road to the West. The blazed trees do not face the position of a single proration - but do work better with position using the fence.
Re-established corner on line between Northwest & Southwest Section corners and on extension of fenceline to East.

C. Description of monument for corner and accessories established to perpetuate locating the position of the corner:
(E-10) Corner is a 1/2"x 24" iron aluminum "Luce Co. Remon" Cap 7' West of centerline road to South and on centerline ext. road to West. Falls on extension of fallen fence to East.

Witnesses: 28" Beech	N30°E	69.11'
10" Ironwood (Existing Blaze-added Nail)	S60°E	46.92'
12" Y. Birch (Existing Blaze-added Nail)	S55°W	48.49'
7" Y. Birch	N72°W	41.52'



Signed by William L. Karr Date 12/22/94

Surveyor's Michigan License No. 27450

NOTE: Bearings are compass bearings corrected for declination. Distances are to a nail in side of witness objects unless noted.