

MAR 19 1999

LAND CORNER RECORDATION CERTIFICATE
 Filing Requirement of Act 74, Mich. P.A. 1970
 Luce County Remonumentation Corner

LUCE COUNTY
 REGISTER OF DEEDS

Recorded

Liber 3 page 843
 01-20-1999 15:04:49
Kathy S. Mahar, Register
 REGISTER OF DEEDS

SECTION

For corners in

Luce County	Located in:	Corner Code #
1. Public Land Survey	T45N R11W	E-13 ✓
	T44N R11W	E-1 (Mackinac Co)
	T R	
	T R	
2. Property Controlling in Section	S T R	
	S T R	
3. Miscellaneous Property in Sec.	S T R	
	S T R	
4. Lot No. , Recorded Plat		
5. Private Claims		

Register of Deeds Stamp & File Number

A	B	C	D	E	F	G	H	I	J	K	L	M
1												
2	6	5	4	3	2	1						
3												
4	7	8	9	10	11	12						
5												
6	18	17	16	15	14	13						
7												
8	19	20	21	22	23	24						
9												
10	30	29	28	27	26	25						
11												
12	31	32	33	34	35	36						
13												

T45N R11W

I, William L. Karr, in a field survey on December 3, 1998, do hereby state that under requirements of P.A. 74, Michigan P.A. of 1970, the corner points mentioned in lines 1 and 2 above were in conformance with regulations and rules therefore as required in the current manual of survey instructions of the United States Department of the Interior, Bureau of Land Management or by a decree of a Court of Law and for that the corner points mentioned in lines 3, 4 and 5 above were in conformance with the rules of the Michigan Board of Land Surveyors or by a Decree of a Court of Law; established, re-established, monumented, recovered, found as expressed below:

NOTE: Not more than 2 corners, all in the same town and range, may be recorded on this certificate.

A. Description of original monument and accessories and/or subsequent restoration:


(E-13) Section Corner Common to Sections 32 & 33, T. 45 N., R. 11 W. and Sections 4 & 5, T. 44 N., R. 11 W.

1841 John Burt set post on township line in original survey.

Witnesses: 9" Cedar N 34° E 16 lks
 10" Black Ash N 60° W 17 lks

1997 William Karr, P.S. 2450, found no evidence of the original corner and re-established the position by single proportionate measurement along the township line between the 1/4 corner 1/2 mile West and a section corner 2 miles East and set 1/2" iron with cap #27450.

Witnesses: 7" Ash N 89° E 5.44' 14" Cedar S 34° E 22.24'
 13" Cedar S 58° W 17.85' 12" Cedar N 31° W 3.16'

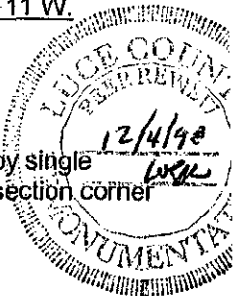

B. Description of corner evidence found and/or method applied in restoring or reestablishing corner:

(E-13) Section Corner Common to Sections 32 & 33, T. 45 N., R. 11 W. and Sections 4 & 5, T. 44 N., R. 11 W.

This corner is being perpetuated as part of the Luce County Remonumentation Program.

Subsequent to the discovery of an original bearing tree for the 1/4 corner 1/2 mile East, a more thorough search of the area around the section corner was conducted. I recovered what I consider to be the original stake point of the post set for the section corner. The stake point falls S 60° E, 6.7' from the position established in 1997 and falls in a wet cedar swamp. No conclusive evidence of the original bearing trees could be recovered. Re-established the section corner at the location of the stake point.


C. Description of monument for corner and accessories established to perpetuate locating the position of the corner:

(E-13) Section Corner Common to Sections 32 & 33, T. 45 N., R. 11 W. and Sections 4 & 5, T. 44 N., R. 11 W.

Corner is a 1/2" x 48" re-bar with a stamped aluminum Luce County Remonumentation cap. The corner falls in a wet cedar swamp 1.0' South of a metal fence post.

Witnesses: Cedar 13" N 88° E 28.46'
 Cedar 12" S 22° E 16.36'
 Cedar 9" S 75° W 21.52'
 Cedar 12" N 45° W 9.49'

Bearings are compass bearings, corrected for declination, all distances are to a nail and tag in the side of the witness object unless otherwise noted.

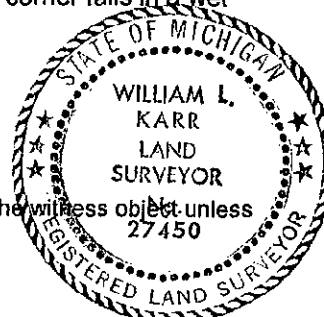

Signed by William L. Karr

Date 12/22/98

Surveyor's Michigan License No. 27450