

# SURVEY & REMONUMENTATION

APR 28 1995

COMMISSION


LUCÉ COUNTY REMONUMENTATION CORNER  
LAND CORNER RECORDATION CERTIFICATE  
Filing Requirement of Act 74, Mich. P.A. 1970

For corners in

Luce <small>(County)</small>	Located In:	Corner Code #	
1. Public Land Survey	T <u>45N</u> R <u>11W</u>	<u>F-5</u>	
	T _____ R _____	_____	
	T _____ R _____	_____	
	T _____ R _____	_____	
2. Property Controlling in Section	S _____ T _____ R _____	_____	
	S _____ T _____ R _____	_____	
3. Miscellaneous Property in Sec.	S _____ T _____ R _____	_____	
	S _____ T _____ R _____	_____	
4. Lot No. _____, Recorded Plat _____			
5. Private Claims _____			

Filed 1/20 A.D., 19 95  
At 12:30 o'clock P.M.  
Liber 2  
File No. Page 583  
*Kathy S. Mahar*  
Luce County Reg. of Deeds

Register of Deeds Stamp & File Number

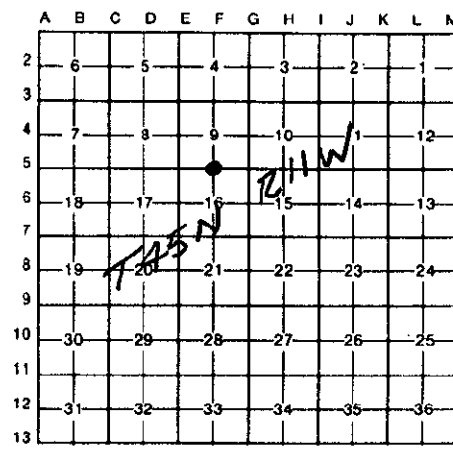


I, William L. Karr, in a field survey on December 16, 19 94, do hereby certify that under requirements of P.A. 74, Michigan P.A. of 1970, the corner points mentioned in lines 1 and 2 above were in conformance with regulations and rules therefore as required in the current manual of survey instructions of the United States Department of the Interior, Bureau of Land Management or by a decree of a Court of Law and/or that the corner points mentioned in lines 3, 4 and 5 above were in conformance with the rules of the Michigan Board of Land Surveyors or by a Decree of a Court of Law, established, re-established, monumented, re-monumented, recovered, found as expressed below.

**NOTE: Not more than 4 corners, all in the same town and range, may be recorded on this certificate.**

A. Description of original monument and accessories and/or subsequent restoration:  
(F-5) 1/4 Corner Sections 9 & 16, T.45 N., R.11 W.  
1849: W. Ives set 1/4 post 6" Sugar S49W 8 lks  
12" Sugar N16E 24 lks

B. Description of corner evidence found and/or method applied in restoring or reestablishing corner:  
(F-5) This corner is being perpetuated as part of the Luce County Remonumentation program.

Found a 1-3/4" pipe 30" above ground and a 1/2" re-rod 3' apart. Found the pipe to be midway and on line between Section corners. Accepted the pipe as the corner position and used the re-rod as a witness.

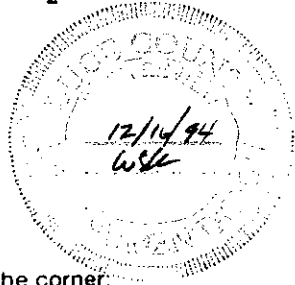

C. Description of monument for corner and accessories established to perpetuate locating the position of the corner:  
(F-5) Corner is a 1-3/4" pipe, 30" above ground, firmly embedded and leaning slightly to the West. Used the top.

Witnesses: 1/2" rerod	N47°E	3.13'
10" Maple	N78°E	26.12'
7" Cherry	S55°E	15.12'
15" Maple	N85°W	4.80'
14" Maple	N22°W	15.54'



Signed by William L. Karr Date 12/22/94  
Surveyor's Michigan License No. 27450

**NOTE: Bearings are compass bearings corrected for declination. Distances are to a nail in side of witness objects unless noted.**