

MAY 28 1997

COMMISSION

LUCE COUNTY REMONUMENTATION CORNER

LAND CORNER RECORDATION CERTIFICATE  
Filing Requirement of Act 74, Mich. P.A. 1970

LUCE COUNTY REGISTER OF DEEDS

For corners in

Luce  
(County)

Located In:

Corner Code #

- 1. Public Land Survey
 

T45N R 11W	✓	G-1	Same
T46N R 11W		G-13	Corner
T ___ R ___			
T ___ R ___			
- 2. Property Controlling in Section
 

S ___ T ___ R ___			
S ___ T ___ R ___			
- 3. Miscellaneous Property in Sec.
 

S ___ T ___ R ___			
S ___ T ___ R ___			


Recorded  
*Liber 2 Page 736*  
02-28-1997 08:58:46  
*Kathy S. Maha*  
Kathy S. Maha, Register  
REGISTER OF DEEDS

Register of Deeds Stamp & File Number

- 4. Lot No. \_\_\_\_\_, Recorded Plat \_\_\_\_\_
- 5. Private Claims \_\_\_\_\_

I, William L. Karr, in a field survey on Dec. 9, 1996 do hereby state that under requirements of P.A. 74, Michigan P.A. of 1970, the corner points mentioned in lines 1 and 2 above were in conformance with regulations and rules therefore as required in the current manual of survey instructions of the United States Department of the Interior, Bureau of Land Management or by a decree of a Court of Law and for that the corner points mentioned in lines 3, 4 and 5 above were in conformance with the rules of the Michigan Board of Land Surveyors or by a Decree of a Court of Law; established, re-established, monumented, recovered, found as expressed below:

NOTE: Not more than 2 corners, all in the same town and range, may be recorded on this certificate.

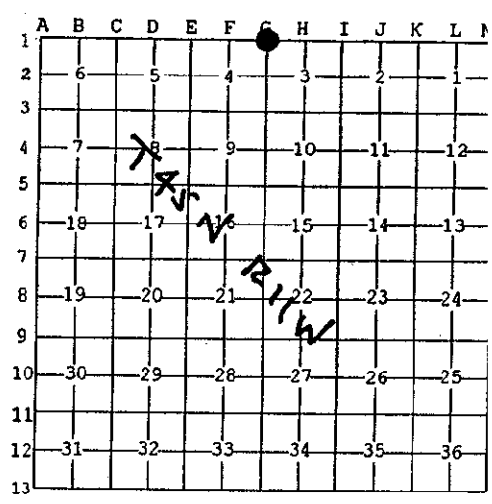

A. Description of original monument and accessories and/or subsequent restoration:


(G-1) Section Corner Common to Sections 3 & 4, T.45 N., R.11 W., and Sections 33 & 34, T.46 N., R.11 W.  
 1841: W.A. Burt set post Hemlock 22 N65°W 19  
 Beech 8 N60°E 49  
 1994: W.L. Karr found a 1/2" pipe with pinched top in approximate centerline of gravel road. (4) witnesses were established.

B. Description of corner evidence found and/or method applied in restoring or reestablishing corner:

(G-1) This Corner is being perpetuated as part of the Luce County Remonumentation Program.  
 Found no evidence of original corner. Found 1/2" pipe as described above. Distance West to 1/4 corner 4 & 33 is 2640.08'; distance East to Township corner is 15,851.91' (distance North is 15,840'). Accepted corner position as found.

C. Description of monument for corner and accessories established to perpetuate locating the position of the corner:

(G-1) Corner is a 1/2" pipe with pinched top in approximate centerline of Gravel Road.  
 Witnesses: 1-1/2" Pipe N06°W 35.40'  
 Chisled [ ] in sign S07°E 32.65'  
 14" Maple S51°W 66.29'  
 14" Maple N36°W 73.21'

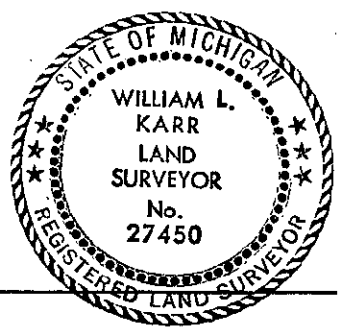

Signed by *William L. Karr*  
 Surveyor's Michigan License No. 27450

Date 12-30-96

NOTE: All bearings are compass bearings corrected for declination. All distances are to a nail in side of witness objects unless noted.