

**SURVEY & REMONUMENTATION**

**APR 07 1998**


**LAND CORNER RECORDATION CERTIFICATE**  
**Filing Requirement of Act 74, Mich. P.A. 1970**  
**Luce County Remonumentation Corner**

For corners in **SECTION**

Luce County	Located in:	Corner Code #
1. Public Land Survey	T45N R11W	G-6
	T R	
	T R	
	T R	
2. Property Controlling in Section	S T R	
	S T R	
3. Miscellaneous Property in Sec.	S T R	
	S T R	
4. Lot No.	Recorded Plat	
5. Private Claims		

LUCE COUNTY  
 REGISTER OF DEEDS  
 Recorded  
*Liber 3 page 777*  
 02-24-1998 14:46:40  
*Kathie S. Mahar, Register*  
 REGISTER OF DEEDS

Register of Deeds Stamp & File Number

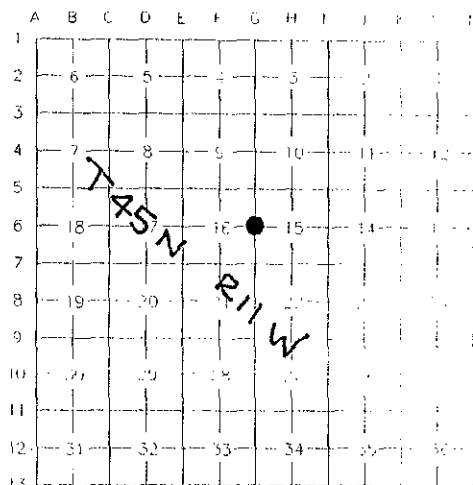

I, William L. Karr, in a field survey on December 19, 1997, do hereby state that under requirements of P.A. 74, Michigan P.A. of 1970, the corner points mentioned in lines 1 and 2 above were in conformance with regulations and rules therefore as required in the current manual of survey instructions of the United States Department of the Interior, Bureau of Land Management or by a decree of a Court of Law and /or that the corner points mentioned in lines 3, 4 and 5 above were in conformance with the rules of the Michigan Board of Land Surveyors or by a Decree of a Court of Law; established, re-established, monumented, recovered, found as expressed below:

NOTE: Not more than 2 corners, all in the same town and range, may be recorded on this certificate.

A. Description of original monument and accessories and/or subsequent restoration:

(G-6) 1/4 Corner Common to Sections 15 and 16, T. 45 N., R. 11 W.

1849 William Ives set post for corner in original survey.  
 Witnesses: 12" Sugar N 70° E 10 lks  
 8" Beech N 67° W 25 lks

Could find no subsequent survey history on this corner in available public records.



B. Description of corner evidence found and/or method applied in restoring or reestablishing corner:

(G-6) 1/4 Corner Common to Sections 15 and 16, T. 45 N., R. 11 W.

This corner is being perpetuated as part of the Luce County Remonumentation Program.

Found remains of possible original BT's. Found large maple down and partially rotted with evidence of scaring consistent with blazing. Also found mound at the location of the beech. The position for the corner works well with GLO. Distance to section corner South 2640' (GLO), 2644.49' (meas). Distance to the meander corner on the North side of a small lake to the North, 1749' (GLO), 1734.91' (meas). The 1/4 corner falls 6.2' West of a line between the section corner and meander corner.


Reestablished 1/4 corner at record bearing and distance from the remains of the 2 trees.

C. Description of monument for corner and accessories established to perpetuate locating the position of the corner:

(G-6) 1/4 Corner Common to Sections 15 and 16, T. 45 N., R. 11 W.

Corner is a 1/2" x 48" re-bar with a stamped aluminum Luce County Remonumentation cap. The corner falls in a wooded area, 37' West of an old North-South fence line.

Witnesses: 17" Beech N 16° E 16.80'  
 8" Sugar Maple S 50° E 18.37'  
 7" Red Maple S 50° W 43.20'  
 9" Beech N 65° W 7.54'

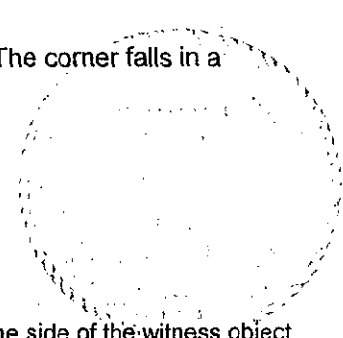

Bearings are compass bearings, corrected for declination (6°W), all distances are to a nail and tag in the side of the witness object unless otherwise noted.

Signed by William L. Karr

Date 12/21/97

Surveyor's Michigan License No. 27450