

APR 01 1996

LUCE COUNTY REMONUMENTATION CORNER

COMMISSION

LAND CORNER RECORDATION CERTIFICATE  
Filing Requirement of Act 74, Mich. P.A. 1970

For corners in

<u>Luce</u> (County)	Located In:	Corner Code #
1. Public Land Survey	T <u>45N</u> R <u>11W</u>	<u>G-7</u>
	T ___ R ___	_____
	T ___ R ___	_____
	T ___ R ___	_____
2. Property Controlling in Section	S ___ T ___ R ___	_____
	S ___ T ___ R ___	_____
3. Miscellaneous Property in Sec.	S ___ T ___ R ___	_____
	S ___ T ___ R ___	_____


LUCE COUNTY  
REGISTER OF DEEDS  
Recorded  
*Liber 2 Page 667*  
02-29-1996 15:11:39  
*Kathy S. Mahar*  
Kathy S. Mahar, Register  
REGISTER OF DEEDS

Register of Deeds Stamp & File Number

4. Lot No. \_\_\_\_\_, Recorded Plat \_\_\_\_\_  
5. Private Claims \_\_\_\_\_

I, William L. Karr, in a field survey on Dec. 13, 1995 do hereby state that under requirements of P.A. 74, Michigan P.A. of 1970, the corner points mentioned in lines 1 and 2 above were in conformance with regulations and rules therefore as required in the current manual of survey instructions of the United States Department of the Interior, Bureau of Land Management or by a decree of a Court of Law and/or that the corner points mentioned in lines 3, 4 and 5 above were in conformance with the rules of the Michigan Board of Land Surveyors or by a Decree of a Court of Law; established, re-established, monumented, recovered, found as expressed below:

NOTE: Not more than 2 corners, all in the same town and range, may be recorded on this certificate.

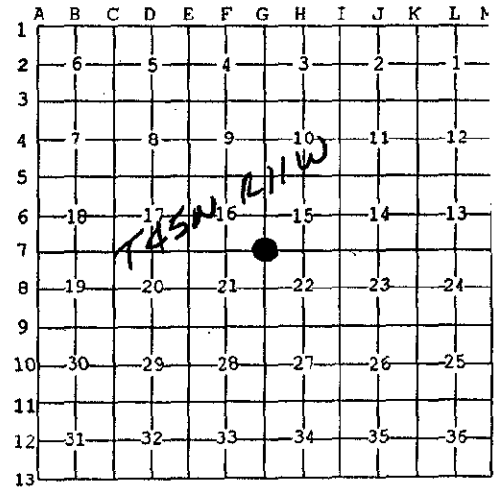

A. Description of original monument and accessories and/or subsequent restoration:

(G-7) Corner of Sections 15, 16, 21 and 22, T45N, R11W

1849: William Ives, set post

14" Beech S36°W 52 links 9" Fir N33°E 16 links

1967: Billy D. Buckler, P.S. 8887. Recorded corner in Liber 1, Page 336 of corner

records. Found pipe set by H. Lawrence with witness pipes Northeast and Southwest at 45.1 feet. Added new witnesses:

14" Soft Maple S38°E 33.6' 13" Y. Birch N40°E 16.2'

B. Description of corner evidence found and/or method applied in restoring or reestablishing corner:

(G-7) This corner is being perpetuated as part of the Luce County Remonumentation program.

Found corner as recorded by Buckler. Ties to Birch and Maple witness trees both match. Ties to witness pipes are both long and are not equal. Accepted position as being that surveyed and recorded by Buckler and added new witnesses.

C. Description of monument for corner and accessories established to perpetuate locating the position of the corner:

(G-7) Corner is a 2" pinched top pipe on North side of East-West woods road. 6" squared wood post is North 1 foot.

Witnesses:	12" Y. Birch	N41°E	16.42'
	14" Red Maple	S35°E	33.97'
	2" Pipe	N49°E	43.65'
	2" Pipe	S49°W	46.50'
	10" Sugar Maple	S78°E	28.10'
	10" Sugar Maple	S81°W	42.44'

Signed by *William L. Karr*  
Surveyor's Michigan License No. 27450

Date 12/26/95

