SURVEY & REMONUMENTATION

APR 28 1995

COMMISSION

LUCE COUNTY REMONUMENTATION CORNER

LAND CORNER RECORDATION CERTIFICATE

Filing Requirement of Act 74, Mich. P.A. 1970

For corners in Luce (County)

	Located In:	Corner Code #
1. Public Land Survey	T 45N R 11W	G-9
	T ___ R ___	
	T ___ R ___	
	T ___ R ___	
2. Property Controlling	S ___ T ___ R ___	
in Section	S ___ T ___ R ___	
3. Miscellaneous	S ___ T ___ R ___	
Property in Sec.	S ___ T ___ R ___	

Filed 1/20 A.D., 1995
At 12:30 o'clock P M.
File No. Liber 2 page 579
Kathy S. Maher
Luce County Reg. of Deeds

Register of Deeds Stamp & File Number

4. Lot No. _____, Recorded Plat _____
5. Private Claims _____

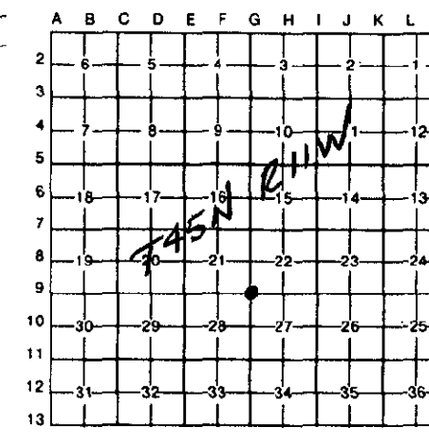

I, William L. Karr, in a field survey on December 06, 19 94, do hereby certify that under requirements of P.A. 74, Michigan P.A. of 1970, the corner points mentioned in lines 1 and 2 above were in conformance with regulations and rules therefore as required in the current manual of survey instructions of the United States Department of the Interior, Bureau of Land Management or by a decree of a Court of Law and/or that the corner points mentioned in lines 3, 4 and 5 above were in conformance with the rules of the Michigan Board of Land Surveyors or by a Decree of a Court of Law; established, re-established, monumented, re-monumented, recovered, found as expressed below:

NOTE: Not more than 4 corners, all in the same town and range, may be recorded on this certificate.

A. Description of original monument and accessories and/or subsequent restoration:

(G-9) Section Corner 21, 22, 27 & 28, T.45 N., R.11 W.

1849: W. Ives set post 10" Tamarack N57W 15 lks
6" Spruce S38E 18 lks

1967: Billy D. Buckler, P.S. 8887 (DNR) (Pg.816 of corner records)
Re-established corner using a corner, ridges, fences to South, a Section corner one mile North, swamp edges, etc.
Set 1" pipe with 4" aluminum cap.
5" Cedar N01°W 21.4'
4" Cedar N51°E 8.4'

B. Description of corner evidence found and/or method applied in restoring or reestablishing corner:

(G-9) This corner is being perpetuated as part of the Luce County Remonumentation program.

Found 1" pipe with aluminum DNR cap and 2 record bearing trees.
Accepted corner position as found. Added two additional bearing trees.

LUCE COUNTY REMONUMENTATION 12/16/94 WLK

C. Description of monument for corner and accessories established to perpetuate locating the position of the corner:

(G-9) Corner is a 1" pipe with aluminum DNR cap, 12" above ground with 4"diameter post (6' tall) next to it. Corner falls in a thick area of scrub Cedars.

Witnesses:		
5" Cedar (Existing - Added Nail)	N47°E	22.01'
6" Twin Cedar	S30°E	10.08'
5" Cedar	S82°W	17.60'
4" Cedar (Existing - Added Nail)	N06°W	8.90'

STATE OF MICHIGAN WILLIAM L. KARR LAND SURVEYOR No. 27450 REGISTERED LAND SURVEYOR

Signed by William L. Karr Date 12/22/94

Surveyor's Michigan License No. 27450

NOTE: Bearings are compass bearings corrected for declination.
Distances are to a nail in side of witness objects unless noted.

FORM APPROVED BY MICHIGAN STATE BOARD OF LAND SURVEYORS, JAN. 28, 1971
REVISED MAY 14, 1975
REVISED JAN., 1983