

**SURVEY &
REMONUMENTATION**

APR 28 1995

COMMISSION

LUCE COUNTY REMONUMENTATION CORNER

LAND CORNER RECORDATION CERTIFICATE


Filing Requirement of Act 74, Mich. P.A. 1970

For corners in

<u>Luce</u> (County)	Located In:	Corner Code #
1. Public Land Survey	T <u>45N</u> R <u>11W</u>	<u>G-11</u>
	T _____ R _____	_____
	T _____ R _____	_____
	T _____ R _____	_____
2. Property Controlling in Section	S _____ T _____ R _____	_____
	S _____ T _____ R _____	_____
3. Miscellaneous Property in Sec.	S _____ T _____ R _____	_____
	S _____ T _____ R _____	_____

Filed 1/20 A.D., 1995
 At 12:30 o'clock P. M.
 Liber 2
 File No. page 380
Kathy J. Mahan
 Luce County Reg. of Deeds
 Register of Deeds Stamp & File Number

4. Lot No. _____, Recorded Plat _____
 5. Private Claims _____

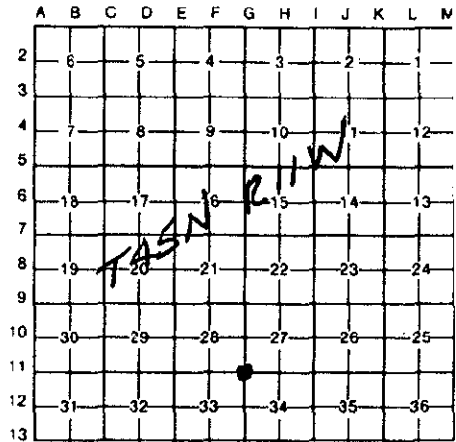

I, William L. Karr, in a field survey on December 16, 1994, do hereby certify that under requirements of P.A. 74, Michigan P.A. of 1970, the corner points mentioned in lines 1 and 2 above were in conformance with regulations and rules therefore as required in the current manual of survey instructions of the United States Department of the Interior, Bureau of Land Management or by a decree of a Court of Law and/or that the corner points mentioned in lines 3, 4 and 5 above were in conformance with the rules of the Michigan Board of Land Surveyors or by a Decree of a Court of Law; established, re-established, monumented, re-monumented, recovered, found as expressed below:

NOTE: Not more than 4 corners, all in the same town and range, may be recorded on this certificate.

A. Description of original monument and accessories and/or subsequent restoration:

(G-11) Section Corner 28, 27, 34 & 35, T.45 N., R.11 W.

1849: W. Ives set post 16" Sugar N18W 19 lks
 14" Lynn S46E 38 lks

1967: Billy D. Buckler, P.S. 8887 (DNR) (Pg.807 of corner records) replaced corner (1-1/4"x 30" pipe) midway between two fence corners to North and South which are 66' apart.
 No witnesses.

B. Description of corner evidence found and/or method applied in restoring or reestablishing corner:


(G-11) This corner is being re-established as part of the Luce County Remonumentation program.

Found no evidence of original corner. Found the fence corners called for by Buckler (though not exactly 66' feet apart).
 Re-established corner midway and on line between the two fence corners.
 Corner works well with others in area.

C. Description of monument for corner and accessories established to perpetuate locating the position of the corner:

(G-11) Corner is a 1/2"x 24" iron with aluminum "Luce County Remonumentation" cap 2' North of the centerline of an East-West gravel road.

Witnesses: Corner fence post	N03°E	32.97'
16" Maple	S75°E	123.94'
8" Tamarack	S44°W	87.12'
7" W. Pine	S73°W	84.37'

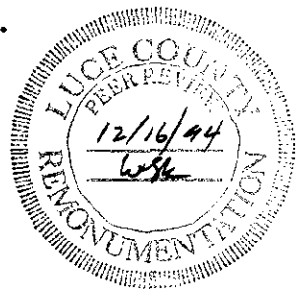

Signed by William L. Karr Date 12/22/94

Surveyor's Michigan License No. 27450

NOTE: Bearings are compass bearings corrected for declination.
 Distances are to a nail in side of witness objects unless noted.