

MAR 19 1999

SECTION


LAND CORNER RECORDATION CERTIFICATE
Filing Requirement of Act 74, Mich. P.A. 1970
Luce County Remonumentation Corner

For corners in

Table with columns: Luce County, Located in:, Corner Code #. Includes entries for Public Land Survey, Property Controlling in Section, Miscellaneous Property in Sec., Lot No., and Private Claims.

LUCE COUNTY REGISTER OF DEEDS Recorded
Liber 3 Page 839
01-20-1999 15:03:31
Kathy S. Mahar, Register
REGISTER OF DEEDS

Register of Deeds Stamp & File Number

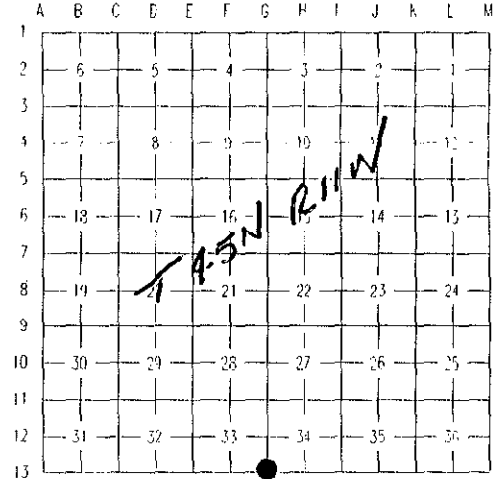

I, William L. Karr, in a field survey on December 2, 1998, do hereby state that under requirements of P.A. 74, Michigan P.A. of 1970, the corner points mentioned in lines 1 and 2 above were in conformance with regulations and rules therefore as required in the current manual of survey instructions of the United States Department of the Interior, Bureau of Land Management or by a decree of a Court of Law and/or that the corner points mentioned in lines 3, 4 and 5 above were in conformance with the rules of the Michigan Board of Land Surveyors or by a Decree of a Court of Law; established, re-established, monumented, recovered, found as expressed below:

NOTE: Not more than 2 corners, all in the same town and range, may be recorded on this certificate.

A. Description of original monument and accessories and/or subsequent restoration:

(G-13) Section Corner Common to Sections 33 & 34, T. 45 N., R. 11 W. and Sections 3 & 4, T. 44 N., R. 11 W.

1841 John Burt set a post for the corner in the original survey.
Witnesses: 7" Tamarack N 34° E 14 lks
8" Tamarack N 44° W 32 lks

Could find no subsequent history on this corner in the available public records.

B. Description of corner evidence found and/or method applied in restoring or reestablishing corner:

(G-13) Section Corner Common to Sections 33 & 34, T. 45 N., R. 11 W. and Sections 3 & 4, T. 44 N., R. 11 W.
This corner is being perpetuated as part of the Luce County Remonumentation Program.

Found probable evidence of the original 8" Tamarack B.T. Found a hollow tamarack stump with evidence of a base blaze at the proper location. Could find no evidence of the tamarack to the Northeast or of the original post. The position for the corner works well with other recovered evidence along the township line. Re-established the corner position at the record bearing and distance from the B.T. stump.

C. Description of monument for corner and accessories established to perpetuate locating the position of the corner:

(G-13) Section Corner Common to Sections 33 & 34, T. 45 N., R. 11 W. and Sections 3 & 4, T. 44 N., R. 11 W.

Corner is a 1/2" x 48" re-bar with a stamped Luce County Remonumentation cap. The corner falls in a very wet, partially flooded area.

Table listing witnesses: Cedar Post, Cedar 8", Tamarack 8", Cedar 7", Cedar 8", Charred remains of rubber boots with bearings and distances.

Bearings are compass bearings, corrected for declination, all distances are to a nail and tag in the side of the witness object unless otherwise noted.

Signed by [Signature]

Date 12/22/98

Surveyor's Michigan License No. 27450

