

SURVEY & REMONUMENTATION

APR 28 1995

COMMISSION

LUCE COUNTY REMONUMENTATION CORNER

LAND CORNER RECORDATION CERTIFICATE

Filing Requirement of Act 74, Mich. P.A. 1970


For corners in

Luce <small>(County)</small>	Located In:	Corner Code #	
1. Public Land Survey	T <u>45N</u> R <u>11W</u>	H-11	
	T _____ R _____	_____	
	T _____ R _____	_____	
	T _____ R _____	_____	
2. Property Controlling in Section	S _____ T _____ R _____	_____	
	S _____ T _____ R _____	_____	
3. Miscellaneous Property in Sec.	S _____ T _____ R _____	_____	
	S _____ T _____ R _____	_____	

Filed 1/20 A.D., 1995
At 12:30 o'clock P. M.
Liber 2
File No. page 381
Ruthy S. Mahan
Luce County Reg. of Deeds

Register of Deeds Stamp & File Number

4. Lot No. _____, Recorded Plat _____
5. Private Claims _____

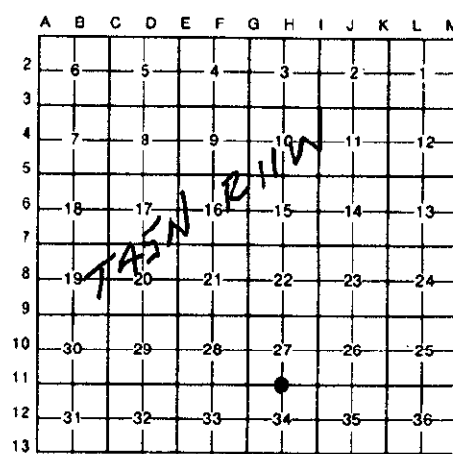

I, William L. Karr, in a field survey on December 07, 1994, do hereby certify that under requirements of P.A. 74, Michigan P.A. of 1970, the corner points mentioned in lines 1 and 2 above were in conformance with regulations and rules therefore as required in the current manual of survey instructions of the United States Department of the Interior, Bureau of Land Management or by a decree of a Court of Law and/or that the corner points mentioned in lines 3, 4 and 5 above were in conformance with the rules of the Michigan Board of Land Surveyors or by a Decree of a Court of Law; established, re-established, monumented, re-monumented, recovered, found as expressed below.

NOTE: Not more than 4 corners, all in the same town and range, may be recorded on this certificate.

A. Description of original monument and accessories and/or subsequent restoration:
(H-11) 1/4 Corner Sections 27 & 34, T.45 N., R.11 W.
1849: W. Ives set 1/4 post 12" Fir S13E 15 lks
 10" Cedar N34W 19 lks
1967: Billy D. Buckler, P.S. 8887 (DNR) (Pg.808 of Corner Records)
 1-1/4"x 30" pipe buried in East-West road.
 Replaced corner midway between 2 fence corners to North and South, 50' apart. No witnesses.

B. Description of corner evidence found and/or method applied in restoring or reestablishing corner:
(H-11) This corner is being perpetuated as part of the Luce County Remonumentation program.

Found the record pipe badly bent. Corner works well with others in area. Accepted corner position as found. Replaced bent pipe with 1/2"x 24" iron and aluminum Luce Co. Remon. Cap.



C. Description of monument for corner and accessories established to perpetuate locating the position of the corner:
(H-11) Corner is a 1/2"x 24" iron with aluminum "Luce County Remonumentation" cap in centerline of gravel road and on the extension of existing fences to the North and South.

Witnesses: 7" Red Pine	N11°E 43.27'
P. Pole (NY3/167D/51)	N50°E 49.71'
11" Cedar	S70°E 60.63'
8" Spruce	S40°W 45.95'
4" Apple	N60°W 37.15'



Signed by William L. Karr Date 12/22/94

Surveyor's Michigan License No. 27450

NOTE: Bearings are compass bearings corrected for declination.
Distances are to a nail in side of witness objects unless noted.