

MAR 19 1999

SECTION

LAND CORNER RECORDATION CERTIFICATE
Filing Requirement of Act 74, Mich. P.A. 1970
Luce County Remonumentation Corner

For corners in

Luce County

Located in:

Corner Code #

1. Public Land Survey

T45N. R11W

H-13

T44N R11W

H-1 (Mackinac Co)

T R

T R

2. Property Controlling in Section

S S

T R T R

3. Miscellaneous Property in Sec.

S S

T R T R

4. Lot No.

Recorded Plat

5. Private Claims

LUCE COUNTY REGISTER OF DEEDS Recorded

Lib 3 page 838

01-20-1999 15:03:06

Karen R Kennel Dep Kathy S. Mahar, Register REGISTER OF DEEDS

Register of Deeds Stamp & File Number

Grid table with columns A-L and rows 1-13. Contains handwritten 'T45N R11W' and a dot in cell J13.

I, William L. Karr, in a field survey on December 3, 1998, do hereby state that under requirements of P.A. 74, Michigan P.A. of 1970, the corner points mentioned in lines 1 and 2 above were in conformance with regulations and rules therefore as required in the current manual of survey instructions of the United States Department of the Interior, Bureau of Land Management or by a decree of a Court of Law and /or that the corner points mentioned in lines 3, 4 and 5 above were in conformance with the rules of the Michigan Board of Land Surveyors or by a Decree of a Court of Law; established, re-established, monumented, recovered, found as expressed below:

NOTE: Not more than 2 corners, all in the same town and range, may be recorded on this certificate.

A. Description of original monument and accessories and/or subsequent restoration:

(H-13) 1/4 Corner Common to Section 34, T. 45 N., R. 11 W. and Section 3, T. 44 N., R. 11 W.

1841 John Burt set post for corner in original survey.

Witnesses: 9" Tamarack N 55° E 18 lks 8" Cedar N 50° W 27 lks

Could find no subsequent survey history on this corner in available public records.



B. Description of corner evidence found and/or method applied in restoring or reestablishing corner:

(H-13) 1/4 Corner Common to Section 34, T. 45 N., R. 11 W. and Section 3, T. 44 N., R. 11 W. This corner is being perpetuated as part of the Luce County Remonumentation Program.


A careful search of the area could recover no evidence of the original corner or of subsequent restoration. Re-established the corner by single proportionate measurement on the township line between the section corners 1/2 mile East and 1/2 mile West.

C. Description of monument for corner and accessories established to perpetuate locating the position of the corner:

(H-13) 1/4 Corner Common to Section 34, T. 45 N., R. 11 W. and Section 3, T. 44 N., R. 11 W.

Corner is a 1/2" x 48" re-bar with a stamped aluminum Luce County Remonumentation cap. The corner falls in a wet cedar swamp.

Witnesses: Cedar 6" N 12° E 7.77' Cedar 11" S 74° E 16.40' Cedar 7" S 31° W 17.07' Cedar 12" N 68° W 18.08'

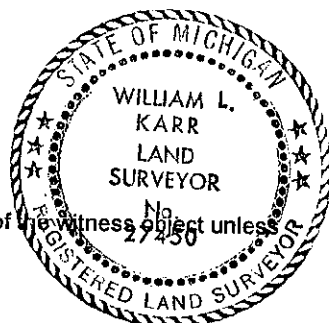

Bearings are compass bearings, corrected for declination, all distances are to a nail and tag in the side of the witness object unless otherwise noted.

Signed by William L. Karr

Date 12/22/98

Surveyor's Michigan License No. 27450