

SURVEY & REMONUMENTATION

APR 28 1995

LUCHE COUNTY REMONUMENTATION CORNER

LAND CORNER RECORDATION CERTIFICATE

Filing Requirement of Act 74, Mich. P.A. 1970


For corners in **COMMISSION**

| | | | |
|---------------------------------------|---------------------------|---------------|--|
| Luce <small>(County)</small> | Located In: | Corner Code # | |
| 1. Public Land Survey | T <u>45N</u> R <u>11W</u> | <u>I-4</u> | |
| | T _____ R _____ | _____ | |
| | T _____ R _____ | _____ | |
| | T _____ R _____ | _____ | |
| 2. Property Controlling in Section | S _____ T _____ R _____ | _____ | |
| | S _____ T _____ R _____ | _____ | |
| 3. Miscellaneous Property in Sec. | S _____ T _____ R _____ | _____ | |
| | S _____ T _____ R _____ | _____ | |

Filed 1/20 A.D., 1995
 At 12:30 o'clock P.M.
 File No. Liber 2 page 591
Wally A. Mahan
 Luce County Reg. of Deeds

Register of Deeds Stamp & File Number

4. Lot No. _____, Recorded Plat _____
 5. Private Claims _____

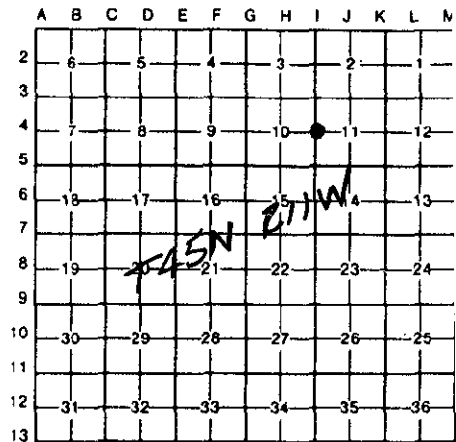

I, William L. Karr, in a field survey on December 16, 1994, do hereby certify that under requirements of P.A. 74, Michigan P.A. of 1970, the corner points mentioned in lines 1 and 2 above were in conformance with regulations and rules therefore as required in the current manual of survey instructions of the United States Department of the Interior, Bureau of Land Management or by a decree of a Court of Law and/or that the corner points mentioned in lines 3, 4 and 5 above were in conformance with the rules of the Michigan Board of Land Surveyors or by a Decree of a Court of Law; established, re-established, monumented, re-monumented, recovered, found as expressed below:

NOTE: Not more than 4 corners, all in the same town and range, may be recorded on this certificate.

A. Description of original monument and accessories and/or subsequent restoration:

(I-4) 1/4 Corner Sections 10 & 11, T.45 N., R.11 W.

1849: W. Ives set 1/4 post 7" Beech N84W 32 lks
 12" Beech N68E 10 lks

1967: J. Smallwood (MDOT) on M-28 R.O.W. plans call for a 3/4" pipe

1978: P. Lapham P.S. 9433 Found a 3/4" Pipe SE cor. headwall N50E 8.09'
 (L.1, Pg.260 of Corner Records) 12" Pine West 33.59'
 12" Maple S80E 13.90'
 Centerline M-28 North 58.20'

Undated: State Hwy Dept. project 48-10 found 2" pipe in gravel road.


B. Description of corner evidence found and/or method applied in restoring or reestablishing corner:

(I-4) This corner is being perpetuated as part of the Luce County Remonumentation program. Found a 1" O.D. pipe which matched distances to Lapham record witness objects. Accepted corner position as found and placed a 1/2" iron inside of pipe and capped with aluminum "Luce County Remonumentation" cap.

C. Description of monument for corner and accessories established to perpetuate locating the position of the corner:

(I-4) Corner is a 1/2" iron placed inside of 1" O.D. pipe and falls 58.2' South of the centerline of M-28.

| | | |
|------------------------------------|-------|--------|
| Witnesses: S.E. corner of headwall | N05°E | 8.08' |
| 12" Maple | S80°E | 13.90' |
| 13" Scotch Pine | S07°E | 11.07' |
| 12" Pine | West | 33.59' |

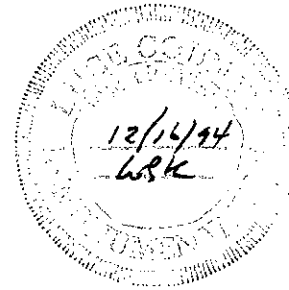

Signed by William L. Karr Date 12/22/94

Surveyor's Michigan License No. 27450

NOTE: Bearings are compass bearings corrected for declination.
 Distances are to a nail in side of witness objects unless noted.