

SURVEY & REMONUMENTATION LAND CORNER RECORDATION CERTIFICATE

Filing Requirement of Act 74, Mich. P.A. 1970

APR 07 1998

Luce County Remonumentation Corner

For corners in

Luce County SECTION Located in: Corner Code #


- | | | | | |
|------------------------------------|---|------|------|---------------|
| 1. Public Land Survey | | T45N | R11W | I-6 |
| | | T | R | |
| | | T | R | |
| | | T | R | |
| 2. Property Controlling in Section | S | T | R | |
| | S | T | R | |
| 3. Miscellaneous Property in Sec. | S | T | R | |
| | S | T | R | |
| 4. Lot No. | | | | Recorded Plat |
| 5. Private Claims | | | | |

LUCE COUNTY
REGISTER OF DEEDS
Recorded

Lib 3 pg 782
02-24-1998 14:47:30

Karen R Wendt-Dip
Kathy S. Mahar, Register
REGISTER OF DEEDS

Register of Deeds Stamp & File Number

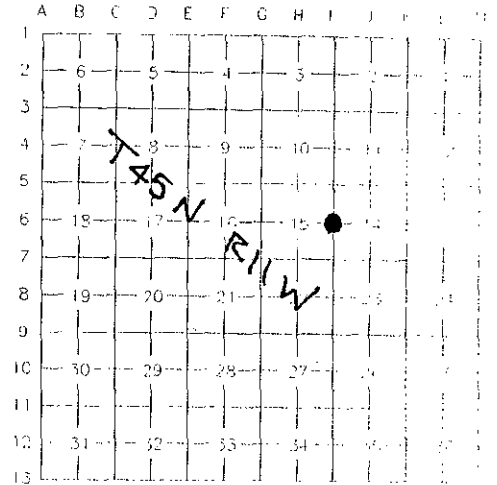

I, William L. Karr, in a field survey on December 12, 1997, do hereby state that under requirements of P.A. 74, Michigan P.A. of 1970, the corner points mentioned in lines 1 and 2 above were in conformance with regulations and rules therefore as required in the current manual of survey instructions of the United States Department of the Interior, Bureau of Land Management or by a decree of a Court of Law and/or that the corner points mentioned in lines 3, 4 and 5 above were in conformance with the rules of the Michigan Board of Land Surveyors or by a Decree of a Court of Law; established, re-established, monumented, recovered, found as expressed below:

NOTE: Not more than 2 corners, all in the same town and range, may be recorded on this certificate.

A. Description of original monument and accessories and/or subsequent restoration:

(I-6) 1/4 Corner Common to Sections 14 and 15, T. 45 N., R. 11 W.

1849 William Ives set post for corner in original survey.

Witnesses:	6" Sugar Maple	S 28° W	9 lks
	12" Sugar Maple	N 18° E	22 lks

Could find no subsequent survey history on this corner in available public records.

B. Description of corner evidence found and/or method applied in restoring or reestablishing corner:

(I-6) 1/4 Corner Common to Sections 14 and 15, T. 45 N., R. 11 W.

This corner is being perpetuated as part of the Luce County Remonumentation Program.

Found no evidence of the original corner. Found a 2" pipe 4.1' South and 0.6' West of a prorated position between the section corner to the South and the meander corner to the North. Accepted the pipe for the 1/4 corner.


C. Description of monument for corner and accessories established to perpetuate locating the position of the corner:

(I-6) 1/4 Corner Common to Sections 14 and 15, T. 45 N., R. 11 W.

Corner is a 2" o.d. pipe projecting 24" above ground and falls in wooded area.

Witnesses:	5" Ironwood	N 01° W	10.60'
	10" Sugar Maple	S 62° E	27.47'
	9" Sugar Maple	S 21° W	34.34'
	10" Sugar Maple	N 82° W	26.19'

Bearings are compass bearings, corrected for declination (6°W), all distances are to a nail and tag in the side of the witness object unless otherwise noted.

 

Signed by *William L. Karr*

Date *12/22/97*

Surveyor's Michigan License No. 27450