

APR 01 1996

LUCE COUNTY REMONUMENTATION CORNER

LAND CORNER RECORDATION CERTIFICATE
Filing Requirement of Act 74, Mich. P.A. 1970

COMMISSION

For corners in

Located In:	Corner Code #
Luce (County)	
1. Public Land Survey	T45N R11W I-7
	T R
	T R
	T R
2. Property Controlling In Section	S T R
	S T R
3. Miscellaneous Property in Sec.	S T R
	S T R


LUCE COUNTY
REGISTER OF DEEDS
Recorded

Liber 2 Page 669
02-29-1996 15:11:58

REGISTER OF DEEDS

Register of Deeds Stamp & File Number

4. Lot No. _____, Recorded Plat _____
5. Private Claims _____

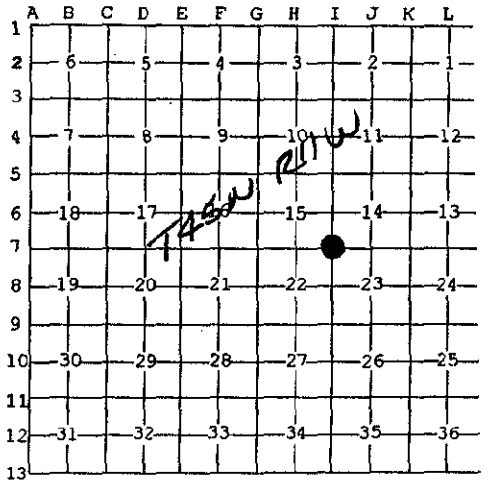

I, William L. Karr, in a field survey on Dec. 13, 1995 do hereby state that under requirements of P.A. 74, Michigan P.A. of 1970, the corner points mentioned in lines 1 and 2 above were in conformance with regulations and rules therefore as required in the current manual of survey instructions of the United States Department of the Interior, Bureau of Land Management or by a decree of a Court of Law and/or that the corner points mentioned in lines 3, 4 and 5 above were in conformance with the rules of the Michigan Board of Land Surveyors or by a Decree of a Court of Law; established, re-established, monumented, recovered, found as expressed below:

NOTE: Not more than 2 corners, all in the same town and range, may be recorded on this certificate.

A. Description of original monument and accessories and/or subsequent restoration:

(I-7) Corner of Sections 14, 15, 22 & 23, T45N, R11W

1849: William Ives, set post

16" Sugar S10°E 31 links 12" Sugar N17°W 53 links

1970: Billy D. Buckler, P.S. 8887. Recorded corner in Liber 1, Page 788 of the Corner Records. Found iron pipe for corner with two witness pipes Northwest and Southeast at 45 feet set by Lawrence. Added two new witnesses.

9" Hard Maple S84°E 26.4' 8" Hard Maple N53°W 44.7'

B. Description of corner evidence found and/or method applied in restoring or reestablishing corner:

(I-7) This corner is being perpetuated as part of the Luce County Remonumentation program.

Found 2" pipe and one maple witness as recorded by Buckler. Also, found 2" witness pipe from Lawrence Southeast at 45 feet. Accepted corner position as found and added witnesses.



C. Description of monument for corner and accessories established to perpetuate locating the position of the corner:

(I-7) Corner is a 2" mushroomed pipe 2" above ground with spike set in center. Pipe falls 16 feet North of centerline 8 feet wide woods road.

Witnesses:	12" Sugar Maple	S81°E	26.59'
	2" Pipe	S42°E	45.03'
	12" Sugar Maple	S54°W	39.12'
	10" Sugar Maple	N35°W	7.82'



Signed by William L. Karr
Surveyor's Michigan License No. 27450

Date 12/26/95