

LUCE COUNTY REMONUMENTATION CORNER

APR 01 1996

LAND CORNER RECORDATION CERTIFICATE
Filing Requirement of Act 74, Mich. P.A. 1970

For corners in

COMMISSION


_____ Luce _____ (County)	Located In:	Corner Code #
1. Public Land Survey	T45N R11W	J-7
	T_____ R_____	_____
	T_____ R_____	_____
	T_____ R_____	_____
2. Property Controlling in Section	S_____ T_____ R_____	_____
	S_____ T_____ R_____	_____
3. Miscellaneous Property in Sec.	S_____ T_____ R_____	_____
	S_____ T_____ R_____	_____

LUCE COUNTY
REGISTER OF DEEDS
Recorded
Liber 2 Page 670
02-29-1996 15:12:07
Kathy S. Mahar
Kathy S. Mahar, Register
REGISTER OF DEEDS

Register of Deeds Stamp & File Number

4. Lot No. _____, Recorded Plat _____
5. Private Claims _____

I, William L. Karr, in a field survey on Dec. 15, 1995 do hereby state that under requirements of P.A. 74, Michigan P.A. of 1970, the corner points mentioned in lines 1 and 2 above were in conformance with regulations and rules therefore as required in the current manual of survey instructions of the United States Department of the Interior, Bureau of Land Management or by a decree of a Court of Law and/or that the corner points mentioned in lines 3, 4 and 5 above were in conformance with the rules of the Michigan Board of Land Surveyors or by a Decree of a Court of Law; established, re-established, monumented, recovered, found as expressed below:

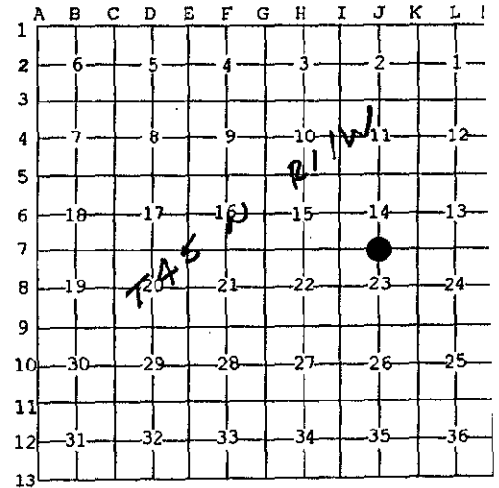


NOTE: Not more than 2 corners, all in the same town and range, may be recorded on this certificate.

A. Description of original monument and accessories and/or subsequent restoration:

(J-7) 1/4 Corner Sections 14 and 23, T45N, R11W
1849: William Ives, set post
8" Beech N43°W 29 links 7" Beech S15°E 10 Links
1967: Billy D. Buckler, P.S. 8887 recorded corner in Liber 1, Page 843 of corner records.
1/2"x 18" iron in road 33.0 feet South of fence corner.
15" Elm S07°E 18.0' 12" Hard Maple S38°W 34.2'

B. Description of corner evidence found and/or method applied in restoring or reestablishing corner:

(J-7) This corner is being perpetuated as part of the Luce County Remonumentation program.
Found 1/2" iron in road centerline and one maple witness as recorded by Buckler.
Accepted corner position as found.

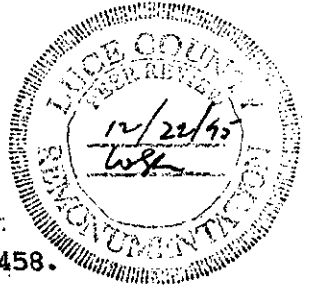

C. Description of monument for corner and accessories established to perpetuate locating the position of the corner:

(J-7) Corner is a 1/2" iron 2" below ground in centerline of County Road 458.

Witnesses:	13" Sugar Maple	S40°W	35.18'
	10" Sugar Maple	S48°E	24.24'
	30" Sugar Maple Clump	N10°E	28.70'
	11" Sugar Maple	N48°W	31.11'



Signed by William L. Karr
Surveyor's Michigan License No. 27450

Date 12/24/95