

SURVEY &
REMONUMENTATION

MAY 28 1997

COMMISSION

LUCE COUNTY REMONUMENTATION CORNER

LAND CORNER RECORDATION CERTIFICATE
Filing Requirement of Act 74, Mich. P.A. 1970

For corners in

Luce (County)	Located In:	Corner Code #
1. Public Land Survey	T45N R 11W ✓ <u>K-11</u> Same	
	T46N R 11W <u>K-13</u> Corner	
	T ___ R ___	
	T ___ R ___	
2. Property Controlling in Section	S ___ T ___ R ___	
	S ___ T ___ R ___	
3. Miscellaneous Property in Sec.	S ___ T ___ R ___	
	S ___ T ___ R ___	

LUCE COUNTY
REGISTER OF DEEDS
Recorded
Liber 2 Page 740
02-28-1997 08:59:36
Kathy S. Mahar
Kathy S. Mahar, Register
REGISTER OF DEEDS

Register of Deeds Stamp & File Number

4. Lot No. _____, Recorded Plat _____
5. Private Claims _____

I, William L. Karr, in a field survey on Dec. 4, 19 96 do hereby state that under requirements of P.A. 74, Michigan P.A. of 1970, the corner points mentioned in lines 1 and 2 above were in conformance with regulations and rules therefore as required in the current manual of survey instructions of the United States Department of the Interior, Bureau of Land Management or by a decree of a Court of Law and /or that the corner points mentioned in lines 3, 4 and 5 above were in conformance with the rules of the Michigan Board of Land Surveyors or by a Decree of a Court of Law; established, re-established, monumented, recovered, found as expressed below:

NOTE: Not more than 2 corners, all in the same town and range, may be recorded on this certificate.

A	B	C	D	E	F	G	H	I	J	K	L
1											
2	6	5	4	3	2	1					
3											
4	7	8	9	10	11	12					
5											
6	16	17	15	14	13						
7											
8	19	20	21	23	24						
9											
10	30	29	28	27	26	25					
11											
12	31	32	33	34	35	36					
13											

T45N R 11W

A. Description of original monument and accessories and/or subsequent restoration:

(K-1) Section Corner Common to Sections 1 & 2, T.45 N., R.11 W. and Sections 35 & 36, T.46 N., R.11 W.
1841: J. Burt for W.A. Burt set 1/4 Section post Tamarack 5 N14°E 31
Cedar 8 N57°W 59

B. Description of corner evidence found and/or method applied in restoring or reestablishing corner:

(K-1) This Corner is being re-established as part of the Luce County Remonumentation Program.
Found no evidence of original corner. Re-established the corner by single proportionate measurement between the Township corner to the East (5283.97') and Section corner 3, 4, 33 & 34 to the West (10,567.94').


C. Description of monument for corner and accessories established to perpetuate locating the position of the corner:

(K-1) Corner is a 1/2" x 24" iron with stamped aluminum Luce County Remonumentation cap.

Witnesses:	8" B. Spruce	N13°E	4.75'
	8" B. Spruce	S54°E	14.27'
	14" Cedar	S35°W	11.60'
	8" B. Spruce	S80°W	8.62'

Signed by William L. Karr
Surveyor's Michigan License No. 27450

Date 12-30-96

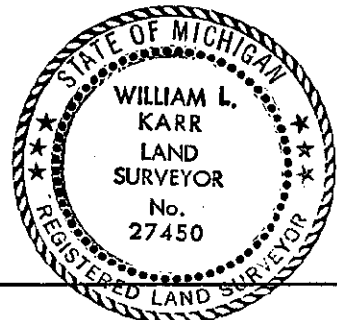

NOTE: All bearings are compass bearings corrected for declination. All distances are to a nail in side of witness objects unless noted.