

LUCE COUNTY REMONUMENTATION CORNER

APR 6 1 1996

LAND CORNER RECORDATION CERTIFICATE
Filing Requirement of Act 74, Mich. P.A. 1970

For corners in COMMISSION

Locality (County)	Located In:	Corner Code #
1. Public Land Survey	T45N R11W	L-7
	T___ R___	_____
	T___ R___	_____
	T___ R___	_____
2. Property Controlling in Section	S___ T___ R___	_____
	S___ T___ R___	_____
3. Miscellaneous Property in Sec.	S___ T___ R___	_____
	S___ T___ R___	_____

LUCE COUNTY
REGISTER OF DEEDS
Recorded
Lib 2 page 674
02-29-1996 15:12:56
Kathy S. Mahar
Kathy S. Mahar, Register
REGISTER OF DEEDS

Register of Deeds Stamp & File Number

4. Lot No. _____, Recorded Plat _____
5. Private Claims _____

I, William L. Karr, in a field survey on Dec. 15, 1995 do hereby state that under requirements of P.A. 74, Michigan P.A. of 1970, the corner points mentioned in lines 1 and 2 above were in conformance with regulations and rules therefore as required in the current manual of survey instructions of the United States Department of the Interior, Bureau of Land Management or by a decree of a Court of Law and /or that the corner points mentioned in lines 3, 4 and 5 above were in conformance with the rules of the Michigan Board of Land Surveyors or by a Decree of a Court of Law, established, re-established, monumented, recovered, found as expressed below:

	A	B	C	D	E	F	G	H	I	J	K	L	M
1													
2	6		5		4		3		2		1		
3													
4	7		8		9		10		11		12		
5													
6	18		17		16		15		14		13		
7													
8	19		20		21		22		23		24		
9													
10	30		29		28		27		26		25		
11													
12	31		32		33		34		35		36		
13													

NOTE: Not more than 2 corners, all in the same town and range, may be recorded on this certificate.

A. Description of original monument and accessories and/or subsequent restoration:

(L-7) 1/4 Corner Sections 13 & 24, T45N, R11W

1849: William Ives, "set post

18" Sugar S39°E 26 links

10" Sugar N64°W 12 links


1987: Howard Walker, P.S. 30105 set 1/2" rebar with cap for corner 5 feet North of East-West gravel road.

Witnesses:	18" Maple	N43°W	36.37'
	16" Maple	N50°E	46.50'
	18" Maple	S02°W	70.62'
	1/2" iron w/cap #30105	West	15.87'

B. Description of corner evidence found and/or method applied in restoring or reestablishing corner:

(L-7) This corner is being perpetuated as part of the Luce County Remonumentation program.

Found bent 1/2" iron 36" below new road surface. Position of iron matches three existing witness trees. Accepted corner position as found and raised to surface with 1/2" x 48" re-rod w/cap #27450 and added new witness.

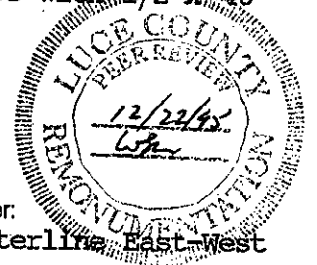

C. Description of monument for corner and accessories established to perpetuate locating the position of the corner:

(L-7) Corner is a 1/2" x 48" re-rod with cap #27450 7 feet North of centerline East-West of County Road 458.

Witnesses:	20" Sugar Maple	N35°W	36.56'	(existing)
	18" Sugar Maple	N60°E	46.56'	(existing)
	15" Beech	S40°E	93.85'	
	20" Sugar Maple	S10°W	70.70'	(existing)



Signed by William L. Karr
Surveyor's Michigan License No. 27450

Date 12/26/95

NOTE: Bearings are compass bearings corrected for declination. Distances are to a nail in side of witness objects unless noted.