

APR 01 1996

LUCE COUNTY REMONUMENTATION CORNER

LAND CORNER RECORDATION CERTIFICATE
Filing Requirement of Act 74, Mich. P.A. 1970

COMMISSION

For corners in

Luce _____ Located In: _____ Corner Code # _____
(County)

1. Public Land Survey T45N R11W ✓ (M-7) Same
T45N R10W (A-7) Corner
T _____ R _____
T _____ R _____

2. Property Controlling S _____ T _____ R _____
in Section S _____ T _____ R _____

3. Miscellaneous S _____ T _____ R _____
Property in Sec. S _____ T _____ R _____

LUCE COUNTY
REGISTER OF DEEDS
Recorded
Liber 2 Page 675
02-29-1996 15:43:08
Kathy S. Mahar
Kathy S. Mahar, Register
REGISTER OF DEEDS

Register of Deeds Stamp & File Number

4. Lot No. _____, Recorded Plat _____
5. Private Claims _____

I, William L. Karr, in a field survey on Dec. 15, 1995 do hereby state that under requirements of P.A. 74, Michigan P.A. of 1970, the corner points mentioned in lines 1 and 2 above were in conformance with regulations and rules therefore as required in the current manual of survey instructions of the United States Department of the Interior, Bureau of Land Management or by a decree of a Court of Law and /or that the corner points mentioned in lines 3, 4 and 5 above were in conformance with the rules of the Michigan Board of Land Surveyors or by a Decree of a Court of Law; established, re-established, monumented, recovered, found as expressed below:

NOTE: Not more than 2 corners, all in the same town and range, may be recorded on this certificate.

A	B	C	D	E	F	G	H	I	J	K	L	M
1												
2	6		5		4		3		2		1	
3												
4	7		8		9		10		11		12	
5												
6	18		17		16		15		14		13	
7												
8	19		20		21		22		23		24	
9												
10	30		29		28		27		26		25	
11												
12	31		32		33		34		35		36	
13												

A. Description of original monument and accessories and/or subsequent restoration:

(M-7) Corner of Secs. 13 & 24, T45N, R11W and Secs. 18 and 19, T45N, R10W (A-7)


1841: John Burt set post
7" Beech N58°E 93 links 10" Sugar N27°W 24 links

1985: Eino Sainio, P.S. 7873 recorded corner in Liber 1, Page 362 of the corner records. Found re-bar with cap #24599. Kelley set in centerline East-West county road with fences North and South. Witnesses:
10" Hard Maple N28°W 43.2' 6" Iron Wood N23°E 42.5'
Corner Fence Post North 43.0' P. Pole S30°W 40.7'

B. Description of corner evidence found and/or method applied in restoring or reestablishing corner:

(M-7) This corner is being perpetuated as part of the Luce County Remonumentation program.

Found 1/2" iron with remains of a plastic cap in centerline of East-West County Road on extension of old fenceline to North and Maple witness to Northwest as recorded by Sainio in 1985. Accepted corner position as found.

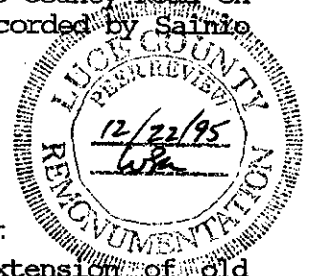

C. Description of monument for corner and accessories established to perpetuate locating the position of the corner:

(M-7) Corner is a 1/2" iron in centerline of County Road 458 on extension of old fenceline to North and 17 feet West of new fence to South.

Witnesses: 10" Maple N31°W 43.39'
4" Balsam N60°E 58.09'
2nd. Post East of Corner S20°E 50.14'
P. Pole (NY2/22/46) S20°W 37.42'



Signed by William L. Karr
Surveyor's Michigan License No. 27450

Date 12/26/95