

Mar 19 1999

**LAND CORNER RECORDATION CERTIFICATE**  
**Filing Requirement of Act 74, Mich. P.A. 1970**  
**Luce County Remonumentation Corner**

SECTION

For corners in


Luce County	Located in:	Corner Code #
1. Public Land Survey	T45N R11W	G-5/G-6
	T R	(South)
	T R	
	T R	#9
2. Property Controlling in Section	S T R	
	S T R	
3. Miscellaneous Property in Sec.	S T R	
	S T R	
4. Lot No.	Recorded Plat	
5. Private Claims		

LUCE COUNTY  
 REGISTER OF DEEDS  
 Recorded  
*Liber 3 Page 840*  
 01-20-1999 15:03:58  
*Karna Wendt*  
 Kathy S. Mahar, Register  
 REGISTER OF DEEDS

Register of Deeds Stamp & File Number

I, William L. Karr, in a field survey on December 10, 1998, do hereby state that under requirements of P.A. 74, Michigan P.A. of 1970, the corner points mentioned in lines 1 and 2 above were in conformance with regulations and rules therefore as required in the current manual of survey instructions of the United States Department of the Interior, Bureau of Land Management or by a decree of a Court of Law and /or that the corner points mentioned in lines 3, 4 and 5 above were in conformance with the rules of the Michigan Board of Land Surveyors or by a Decree of a Court of Law; established, re-established, monumented, recovered, found as expressed below:

NOTE: Not more than 2 corners, all in the same town and range, may be recorded on this certificate.

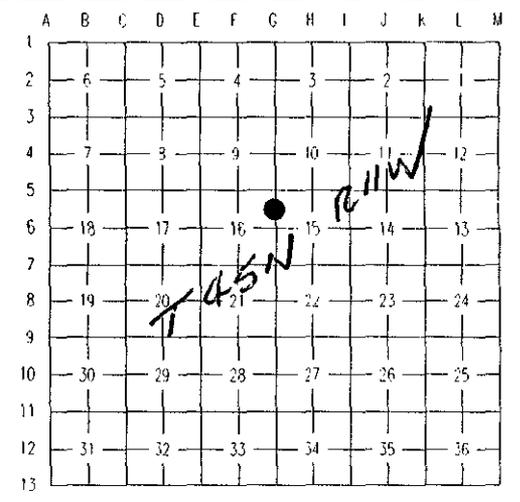

A. Description of original monument and accessories and/or subsequent restoration:

(G-5/G-6) South Meander Corner Between Sections 15 and 16, T. 45 N., R. 11 W.

1849 Wm. Ives set a post in the original survey on the Southwest side of a small lake.  
 Witnesses: 12" Yellow Birch S 28° E 14 lks  
 9" Hemlock N 50° W 6 lks

Could find no subsequent history on this corner in the available public records.



B. Description of corner evidence found and/or method applied in restoring or reestablishing corner:

(G-5/G-6) South Meander Corner Between Sections 15 and 16, T. 45 N., R. 11 W.  
 This corner is being perpetuated as part of the Luce County Remonumentation Program.

In 1977 Billy Buckler, P.S. 8887 remonumented the meander corner on the North side of the lake from the original B.T.'s and recorded the corner at page 233, Luce County Corner Records. Billy's notes make no mention of any evidence at the meander corner on the South side of the lake. A thorough search of the area revealed no trace of the original corner. The only possible evidence of subsequent restoration was a tree blazed on four sides near the corner position.  
 Re-established the meander corner by single proportionate measurement between the 1/4 corner to the South and the meander corner on the North side of the lake.

C. Description of monument for corner and accessories established to perpetuate locating the position of the corner:

(G-5/G-6) South Meander Corner Between Sections 15 and 16, T. 45 N., R. 11 W.

The corner is a 5/8" x 6' aluminum rod with a stamped Luce County Remonumentation Cap. The corner falls in a marshy area 15' from the waters edge and 1' above ground.

Witnesses:	Hemlock Post	North	1.0'
	Sugar Maple 10"	S 31° W	24.24'
	Hemlock 17"	S 44° W	38.27'
	Hemlock 14"	S 75° W	40.64'
	Hemlock 8"	N 66° W	31.12'



Bearings are compass bearings, corrected for declination, all distances are to a nail and tag in the side of the witness object unless otherwise noted.

Signed by William L. Karr Date 12/22/98

Surveyor's Michigan License No. 27450