

1993

Luce County Remonumentation Program

COMMISSION

LAND CORNER RECORDATION CERTIFICATE
Filing Requirement of Act 74, Mich. P.A. 1970

For corners in
Luce

(County)	Located In:	Corner Code #
1. Public Land Survey	T <u>45N</u> R <u>12W</u>	<u>A-8</u>
	T _____ R _____	_____
	T _____ R _____	_____
	T _____ R _____	_____
2. Property Controlling in Section	S _____ T _____ R _____	_____
	S _____ T _____ R _____	_____
3. Miscellaneous Property in Sec.	S _____ T _____ R _____	_____
	S _____ T _____ R _____	_____
4. Lot No. _____, Recorded Plat _____		
5. Private Claims _____		

Filed 12/22 A.D., 1993

At 10:00 o'clock A. M.

Liber 2
File No. page 508

Kathy S. Mahan
Luce County Reg. of Deeds

Register of Deeds Stamp & File Number

I, William L. Karr, in a field survey on November 19, 19 93, do hereby certify that under requirements of P.A. 74, Michigan P.A. of 1970, the corner points mentioned in lines 1 and 2 above were in conformance with regulations and rules therefore as required in the current manual of survey instructions of the United States Department of the Interior, Bureau of Land Management or by a decree of a Court of Law and/or that the corner points mentioned in lines 3, 4 and 5 above were in conformance with the rules of the Michigan Board of Land Surveyors or by a Decree of a Court of Law; established, re-established, monumented, re-monumented, recovered, found as expressed below:

NOTE: Not more than 4 corners, all in the same town and range, may be recorded on this certificate.

	A	B	C	D	E	F	G	H	I	J	K	L	M
2	6		5		4		3		2		1		
3													
4	7		8		9		10		11		12		
5													
6	18		17		16		15		14		13		
7													
8	19		20		21		22		23		24		
9													
10	30		29		28		27		26		25		
11													
12	31		32		33		34		35		36		
13													

A. Description of original monument and accessories and/or subsequent restoration:
(A-8) West 1/4 Corner Section 19, T45N-R12W and East 1/4 Corner Section 24, T45N-R13W (Range Line and County Line)

1841: Corner established by John Burt for William A. Burt
Set 1/4 Section Post
Sugar 10 S 59 E 13 links
Beech 14 N 54 W 18 links

SURVEY &
REMONUMENTATION


1993

COMMISSION

B. Description of corner evidence found and/or method applied in restoring or reestablishing corner:
Corner perpetuated as part of the Luce County Remonumentation Program. Found two corners in the area. Found a 1 3/4" iron with a flattened top, 1" Below ground that falls on approximate extension of centerline dirt roads to the North and East. Found a 1" O.D. pipe 6" A.G. with a wood post - Northeast 0.9'. Found pipe bears S33°W 37.21' from the 1 3/4" iron. Distance South to the Southwest corner of Section 19 from the 1 3/4" iron is 2640.40'. Accepted 1 3/4" iron as corner position.

C. Description of monument for corner and accessories established to perpetuate locating the position of the corner:
Corner is a 1 3/4" iron with a flattened top, 1" below ground. Falls on approximate extension of centerline Luce County Road 467 to North and East (road curves, dirt).

24" Maple	N54°E	62.31'
8" Aspen	S46°E	26.50'
1" O.D. Pipe	S33°W	37.21'
24" Maple	S84°W	19.66'
15" Aspen	N02°W	9.70'

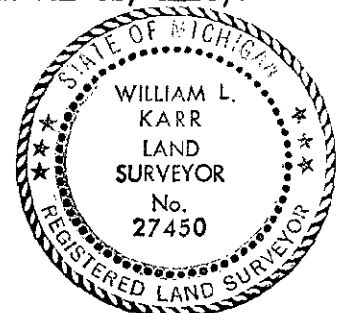

Signed by William L. Karr Date 12/16/93

Surveyor's Michigan License No. 27450

NOTE: Bearings are compass bearings corrected for declination. Distances are to a nail with P.S. 27450 tag in side of witness objects unless noted.