

MAR 13 2000

LAND CORNER RECORDATION CERTIFICATE
Filing Requirement of Act 74, Mich. P.A. 1970
Luce County Remonumentation Corner

SECTION

For corners in

Luce County	Located in:	Corner Code #
1. Public Land Survey	T45N R12W	A-11 ✓
	T45N R13W	M-11 Schoolcraft
	T R	
	T R	
2. Property Controlling in Section	S T R	
	S T R	
3. Miscellaneous Property in Sec.	S T R	
	S T R	
4. Lot No.	Recorded Plat	
5. Private Claims		

LUCE COUNTY
REGISTER OF DEEDS

Recorded
Liber 3 Page 888
02-08-2000 08:29:08
Kathy S. Mahar
Kathy S. Mahar, Register
REGISTER OF DEEDS

Register of Deeds Stamp & File Number

	A	B	C	D	E	F	G	H	I	J	K	L	M
1													
2													
3													
4													
5													
6	18	17	16	15	14	13							
7													
8	19	20	21	22	23	24							
9													
10	30	29	28	27	26	25							
11													
12	31	32	33	34	35	36							
13													

I, William L. Karr, in a field survey on November 8, 1999, do hereby state that under requirements of P.A. 74, Michigan P.A. of 1970, the corner points mentioned in lines 1 and 2 above were in conformance with regulations and rules therefore as required in the current manual of survey instructions of the United States Department of the Interior, Bureau of Land Management or by a decree of a Court of Law and /or that the corner points mentioned in lines 3, 4 and 5 above were in conformance with the rules of the Michigan Board of Land Surveyors or by a Decree of a Court of Law; established, re-established, monumented, recovered, found as expressed below:


NOTE: Not more than 2 corners, all in the same town and range, may be recorded on this certificate.

A. Description of original monument and accessories and/or subsequent restoration:

A-11 Section Corner Common to Sections 30 and 31, Township 45 North, Range 12 West and Sections 25 and 36, Township 45 North, Range 13 West.

1841 John Burt set post for Corner in Original Survey. Witnesses: Cedar 10" S73°W 16 lks
Spruce 15" N36°E 17 lks

1972 Billy D. Buckler, P.S. 8887 re-established corner at intersection of old blaze lines to North, South and East. Set a 1" pipe with 4" aluminum cap and recorded the corner in Liber 1, Page 78 of Luce County Corner Records. Witnesses are 12" Soft Maple N46°E 38.91 feet and 12" Soft Maple N08°W 40.0 feet.

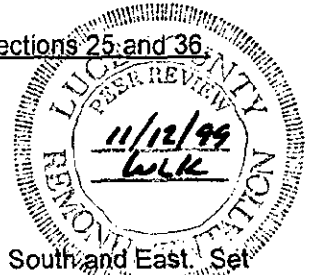

B. Description of corner evidence found and/or method applied in restoring or reestablishing corner:

A-11 Section Corner Common to Sections 30 and 31, Township 45 North, Range 12 West and Sections 25 and 36, Township 45 North, Range 13 West.

This corner is being perpetuated as part of the Luce County Remonumentation Program.

Found no evidence of original corner. Found a 1" pipe with a 4" aluminum D.N.R. cap as recorded by Buckler in 1972.. Accepted corner position as found.

C. Description of monument for corner and accessories established to perpetuate locating the position of the corner:

Corner is a 1" pipe with 4" aluminum D.N.R. cap.

Witnesses:

Red Maple 14"	N06°E	37.08 feet	
Red Maple 16"	N40°E	39.32 feet	(existing)
Spruce 9"	S76°E	24.92 feet	
Balsam 8"	N35°W	34.32 feet	
Red Maple 14"	N12°W	40.64 feet	(existing)



Bearings are compass bearings, corrected for declination (6° W), all distances are to a nail and tag in the side of the witness object unless otherwise noted.

Signed by *William L. Karr*

Date 12/29/99

Surveyor's Michigan License No. 27450