

# SURVEY & REMONUMENTATION

APR 28 1995

## LUCE COUNTY REMONUMENTATION CORNER

### LAND CORNER RECORDATION CERTIFICATE

Filing Requirement of Act 74, Mich. P.A. 1970

### COMMISSION

For corners in

<u>Luce</u> (County)	Located In:	Corner Code #:
1. Public Land Survey	T <u>45N</u> R <u>12W</u>	D-9
	T _____ R _____	_____
	T _____ R _____	_____
	T _____ R _____	_____
2. Property Controlling in Section	S _____ T _____ R _____	_____
	S _____ T _____ R _____	_____
3. Miscellaneous Property in Sec.	S _____ T _____ R _____	_____
	S _____ T _____ R _____	_____
4. Lot No. _____, Recorded Plat _____		
5. Private Claims _____		

Filed 1/20 AD., 1995

At 12:30 o'clock P.M.

File No. Page 590

Robert S. Mahan  
Luce County Reg. of Deeds

Register of Deeds Stamp & File Number

I, William L. Karr, in a field survey on December 20, 1994, do hereby certify that under requirements of P.A. 74, Michigan P.A. of 1970, the corner points mentioned in lines 1 and 2 above were in conformance with regulations and rules therefore as required in the current manual of survey instructions of the United States Department of the Interior, Bureau of Land Management or by a decree of a Court of Law and/or that the corner points mentioned in lines 3, 4 and 5 above were in conformance with the rules of the Michigan Board of Land Surveyors or by a Decree of a Court of Law; established, re-established, monumented, re-monumented, recovered, found as expressed below:

**NOTE: Not more than 4 corners, all in the same town and range, may be recorded on this certificate.**

A. Description of original monument and accessories and/or subsequent restoration:  
(D-9) 1/4 Corner Sections 20 & 29, T.45 N., R.12 W.

1849: G.H. Carleton set 1/4 post 10" Sugar S20E 12 lks  
14" Sugar N60W 46 lks

B. Description of corner evidence found and/or method applied in restoring or reestablishing corner:

(D-9) This corner is being re-established as part of the Luce County Remonumentation program.



Could find no evidence or record of corner position. Re-established corner position midway between Northwest and Northeast Section corners and determined North-South position by a split of R.O.W. fences 33 feet North and 33 feet South.

C. Description of monument for corner and accessories established to perpetuate locating the position of the corner:

(D-9) Corner is a 1/2"x 24" iron with plastic cap No. 27450 on the centerline of the East-West road and 15' East of the centerline of a road to the North.

Witnesses: 6" Ash	N64°E	133.61'
28" Aspen	S73°E	89.62'
P. Pole (NY3/218)	S52°W	57.40'
P. Pole (NY3/218M)	N29°W	71.23'

A	B	C	D	E	F	G	H	I	J	K	L	M
2	6	5	4	3	2	1						
3												
4	7	8	9	10	11	12						
5												
6	18	17	16	15	14	13						
7												
8	19	20	21	22	23	24						
9												
10	30	29	28	27	26	25						
11												
12	31	32	33	34	35	36						
13												

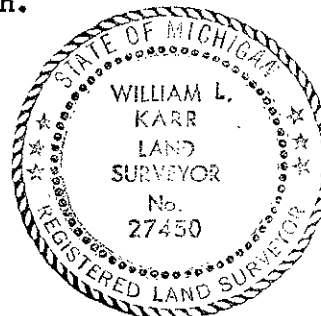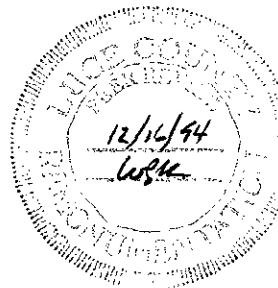

Signed by William L. Karr Date 12/22/94

Surveyor's Michigan License No. 27450

NOTE: Bearings are compass bearings corrected for declination.

Distances are to a nail in side of witness objects unless noted.